

NOTICE OF INTENTION TO DRILL

(see rules on reverse side)

Starting Date 7 30 87 month day year

API Number 15- 167-22, 784-00-00

OPERATOR: License # 5146 Name Rains & Williamson Oil Co., Inc. Address 435 Page Court, 220 West Douglas City/State/Zip Wichita, Kansas 67202 Contact Person Juanita Green Phone (316) 265-9686

E/2 NW NW Sec. 19 Twp. 11 S, Rg. 14 West 4620 Ft. from South Line of Section 4290 Ft. from East Line of Section

(Note: Locate well on Section Plat on reverse side)

CONTRACTOR: License # 5146 Name Same as Above City/State

Nearest lease or unit boundary line 660 feet County Russell Lease Name CHRYSLER-RODA "B" Well # 1

Well Drilled For: Well Class: Type Equipment: X Oil SWD Infield X Mud Rotary X Gas Inj Pool Ext Air Rotary OWWO Expl Wildcat Cable

Ground surface elevation feet MSL Domestic well within 330 feet: yes no Municipal well within one mile: yes no Depth to bottom of fresh water 75 Depth to bottom of usable water 525 Surface pipe by Alternate: 1 2 X Surface pipe planned to be set 255 Conductor pipe required -0- Projected Total Depth 3450 feet Formation Arbuckle

If OWWO: old well info as follows: Operator Well Name Comp Date Old Total Depth

I certify that well will comply with K.S.A. 55-101, et seq., plus eventually plugging hole to KCC specifications. Date 7-24-87 Signature of Operator or Agent WILSON RAINS Title PRESIDENT


For KCC Use: Conductor Pipe Required feet; Minimum Surface Pipe Required 200 feet per Alt. X (2) This Authorization Expires 1-27-88 Approved By R.H. 7-27-87

Must be filed with the K.C.C. five (5) days prior to commencing well  
This card void if drilling not started within six (6) months of date received by K.C.C.

### Important procedures to follow:

1. Notify District office before setting surface casing.
2. Set surface casing by circulating cement to the top.
3. File completion forms ACO-1 with K.C.C. within 90 days of well completion, following instructions on ACO-1, side 1, and including copies of wireline logs.
4. Notify District office 48 hours prior to old well workover or re-entry.
5. Prior to filing Intent, prepare a proposed plugging plan in case well is D & A, then obtain approval of plan when calling district office prior to setting surface pipe.
6. Submit plugging report (CP-4) to K.C.C. after plugging is completed.
7. Obtain an approved injection docket number before disposing of salt water.
8. Notify K.C.C. within 10 days when injection commences or terminates.
9. If an alternate 2 completion, cement in the production pipe from below any usable water to surface within 120 days of spud date.

### A Regular Section of Land 1 Mile = 5,280 Ft.

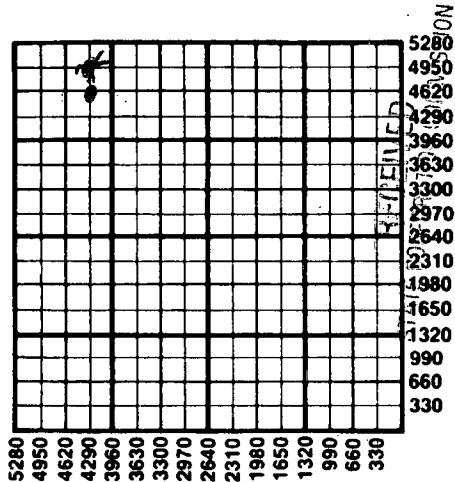

JUL 27 1987

7-27-1987  
CONSERVATION DIVISION  
Wichita, Kansas

State Corporation Commission of Kansas  
Conservation Division  
200 Colorado Derby Building  
Wichita, Kansas 67202  
(316) 263-3238

120 days

CARD MUST BE TYPED

State of Kansas

CARD MUST BE SIGNED

NOTICE OF INTENTION TO DRILL

(see rules on reverse side)

Starting Date 7 month 30 day 87 year

API Number 15-167-22,784-00-00

OPERATOR: License # 5146
Name Rains & Williamson Oil Co., Inc.
Address 435 Page Court, 220 West Douglas
City/State/Zip Wichita, Kansas 67202
Contact Person Juanita Green
Phone (316) 265-9686

E/2 NW NW Sec. 19 Twp. 11 S, Rg. 14 West
4290 Ft. from South Line of Section
4290 Ft. from East Line of Section

(Note: Locate well on Section Plat on reverse side)

CONTRACTOR: License # 5146
Name Same as Above
City/State

Nearest lease or unit boundary line 660 feet
County Russell
Lease Name CHRISLER-RODA "B" Well # 1

Well Drilled For: Well Class: Type Equipment:
X Oil SWD Infield X Mud Rotary
X Gas Inj Pool Ext Air Rotary
OWWO Expl X Wildcat Cable

Ground surface elevation feet MSL
Domestic well within 330 feet: yes no
Municipal well within one mile: yes no
Depth to bottom of fresh water 75
Depth to bottom of usable water 525
Surface pipe by Alternate: 1 2 X
Surface pipe planned to be set 255
Conductor pipe required -0-
Projected Total Depth 3450 feet
Formation Arbuckle

If OWWO: old well info as follows:
Operator
Well Name
Comp Date Old Total Depth

I certify that well will comply with K.S.A. 55-101, et seq., plus eventually plugging hole to KCC specifications.
Date 7-24-87 Signature of Operator or Agent WILSON RAINS Title PRESIDENT

For KCC Use:
Conductor Pipe Required feet; Minimum Surface Pipe Required 200 feet per Alt. X 2
This Authorization Expires 1-27-88 Approved By P.H. 7-27-87

7-1-87
Larry Williamson

Pond water

250' N & 50' E of
SW SE SW Sec. 18 Twp. 11 S, Rg. 14 West

PLUGGING PROPOSAL IF ABOVE IS D & A

This plugging proposal will be reviewed and approved or revised at the time the district office is called prior to setting surface casing (call 7 a.m. to 5 p.m. workdays).

1st plug @ 910 feet depth with 25 sxs of 60-40 poz, 6% gel
2nd plug @ 480 feet depth with 90 sxs of 60-40 poz, 6% gel
3rd plug @ 40 feet depth with 10 sxs of 60-40 poz, 6% gel
4th plug @ feet depth with sxs of
5th plug @ feet depth with sxs of
(2) Rathole with 15 sxs (b) Mousehole with sxs

NOTE: Agreement between operator and district office on plug placement and the amount of cement to be used is necessary prior to plugging.
In Addition: Call district office after well is either plugged or production casing is cemented in.
(Call 7 a.m. to 5 p.m. workdays)

District office use only:
API #15-167-22,784
Surface casing of feet set with sxs at 19
Alternate 1 or 2 surface pipe was used.
Alternate 2 cementing was completed @ ft. depth with sxs on 19
Hole plugged 19, agent

RECEIVED
COMMISSION
9-1-1987
SEP 1 1987
hours, 19

WICHITA DIVISION
WICHITA, KANSAS