

CARD MUST BE TYPED

State of Kansas  
**NOTICE OF INTENTION TO DRILL**

CARD MUST BE SIGNED

(see rules on reverse side)

Starting Date: ..... January 31, 1985 .....  
month day year

API Number 15- 167-22,562-00-00

OPERATOR: License # 6725

SE. NE. SE. Sec 25. Twp 11. S. Rge 14.  East  
(location)  West

Name Eric Waddell Company

Address Box 349

City/State/Zip Natoma, Kansas

Contact Person Eric Waddell

Phone 913-885-4497

1650..... Ft North from Southeast Corner of Section

500..... Ft West from Southeast Corner of Section

(Note: Locate well on Section Plat on reverse side)

CONTRACTOR: License # 4083

Nearest lease or unit boundary line ..... 500 ..... feet.

County Russell

Name Western Kansas Drilling, Inc

Lease Name Terry Well# #1

City/State Hays, Kansas

Domestic well within 330 feet:  yes  no

Municipal well within one mile:  yes  no

Well Drilled For: Well Class: Type Equipment:

- Oil  Swd  Infield  Mud Rotary
- Gas  Inj  Pool Ext.  Air Rotary
- OWWO  Expl  Wildcat  Cable

Depth to Bottom of fresh water ..... 100 ..... feet

Lowest usable water formation .. Dakota ..

Depth to Bottom of usable water ..... 400 450 <sup>in ft</sup> ..... feet

Surface pipe by Alternate: 1  2

Surface pipe to be set ..... 220 ..... feet

Conductor pipe if any required ..... none ..... feet

Ground surface elevation ..... N/A ..... feet MSL

This Authorization Expires ~~July 31, 1985~~ 7-29-85

Approved By 1-29-85

If OWWO: old well info as follows:

Operator .....

Well Name .....

Comp Date ..... Old Total Depth .....

Projected Total Depth ..... 3800 ..... feet

Projected Formation at TD ..... Arbuckle .....

Expected Producing Formations ..... L-KC .....

I certify that we will comply with K.S.A. 55-101, et seq., plus eventually plugging hole to K.C.C. specifications.

Date Jan. 21, 1985 Signature of Operator or Agent

*Eric F. Waddell* Title


*Geologist - Operator*

MHC/MOHE 1-29-85 Form C-1 4/84

Must be filed with the K.C.C. five (5) days prior to commencing well  
 This card void if drilling not started within six (6) months of date received by K.C.C.

**Important procedures to follow:**

**A Regular Section of Land**  
**1 Mile = 5,280 Ft.**

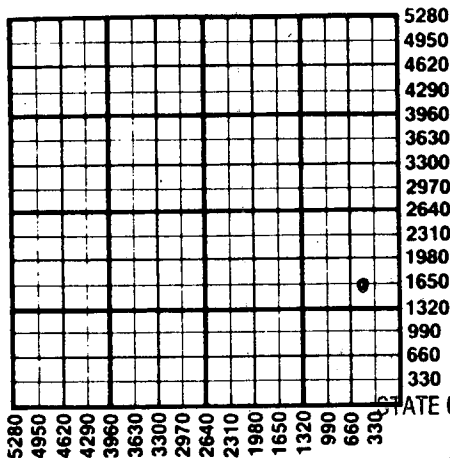

1. Notify District office before setting surface casing.
2. Set surface casing by circulating cement to the top.
3. File completion forms ACO-1 with K.C.C. within 90 days of well completion, following instructions on ACO-1, side 1, and including copies of wireline logs.
4. Notify District office 48 hours prior to old well workover or re-entry.
5. Prior to plugging, prepare a plugging plan, then obtain agreement from the appropriate district office for an approved plugging plan.
6. Submit plugging report (CP-4) to K.C.C. after plugging is completed.
7. Obtain an approved injection docket number before disposing of salt water.
8. Notify K.C.C. within 10 days when injection commences or terminates.

9. If an alternate 2 completion, cement in the production pipe from below any usable water to surface within 120 days of spud date.

RECEIVED  
 STATE CORPORATION COMMISSION

1-29-1985  
 JAN 29 1985

CONSERVATION DIVISION  
 Wichita, Kansas

State Corporation Commission of Kansas  
 Conservation Division  
 200 Colorado Derby Building  
 Wichita, Kansas 67202  
 (316) 263-3238

CARD MUST BE TYPED

State of Kansas  
NOTICE OF INTENTION TO DRILL  
(see rules on reverse side)

**PLUGGED**

FORMS BE SIGNED

Starting Date: January 31, 1985  
month day year

API Number IS- 167-22-562-00-00

OPERATOR: License # 6725  
Name Eric Waddell Company  
Address Box 349  
City/State Zip Natoma, Kansas 67651  
Contact Person Eric Waddell  
Phone 913-885-4497

SE. NE. SE. Sec 25. Twp 11. S. Rge 14.  East  West  
(Location)  
1650 Ft North from Southeast Corner of Section  
500 Ft West from Southeast Corner of Section  
(Note: Locate well on Section Plat on reverse side)

CONTRACTOR: License # 4083  
Name Western Kansas Drilling Inc  
City/State Hays, Kansas

Nearest lease or unit boundary line 500 feet  
County Russell  
Lease Name Terry Well# #1  
Domestic well within 330 feet:  yes  no  
Municipal well within one mile:  yes  no

Well Drilled For: Well Class: Type Equipment:  
 Oil  Swd  Infield  Mud Rotary  
 Gas  Inj  Pool Ext.  Air Rotary  
 OWWO  Expl  Wildcat  Cable

Depth to Bottom of fresh water 100 feet  
Lowest usable water formation Dakota  
Depth to Bottom of usable water 400 450 feet  
Surface pipe by Alternate: 1  2   
Surface pipe to be set 220 feet  
Conductor pipe if any required none feet  
Ground surface elevation N/A feet MSL  
This Authorization Expires ~~July 29, 1985~~ 7-29  
Approved By 1-29-85

If OWWO: old well info as follows:  
Operator  
Well Name  
Comp Date Old Total Depth  
Projected Total Depth 3800 feet  
Projected Formation at TD Arbuckle  
Expected Producing Formations L-KC

I certify that we will comply with K.S.A. 55-101, et seq., plus eventually plugging hole to K.C.C. specifications.

Date Jan. 21, 1985 Signature of Operator or Agent Eric F. Waddell Title Geologist - Operator  
MHC/MONE 1-29-85 Form C-1 4/84

RECEIVED  
STATE CORPORATION COMMISSION  
3-4-1985  
MAR 04 1985

CONSERVATION DIVISION  
Wichita, Kansas