

CARD MUST BE TYPED

State of Kansas

CARD MUST BE SIGNED

NOTICE OF INTENTION TO DRILL

CORRECTION

(see rules on reverse side)

Starting Date .. Est. 9 24 86
month day year

API Number 15— 179-20,871-00-30-1986

OPERATOR: License # 6114
Name DON E. Pratt
Address P. O. Box 370
City/State/Zip .. Hays, Kansas .. 67601
Contact Person .. Don E. Pratt
Phone 913-625-3446

SE. SW. SW. Sec. 31 ... Twp. 10 ... S, Rg. 30 ... West
..... 330 Ft. from South Line of Section
..... 4290 Ft. from East Line of Section

(Note: Locate well on Section Plat on reverse side)

CONTRACTOR: License # 6033
Name Murfin Drilling Company
City/State Wichita, Kansas 67202

Nearest lease or unit boundary line 330 feet
County Sheridan
Lease Name Beckman Well # 6-31

Well Drilled For: Well Class: Type Equipment:
 Oil SWD Infield Mud Rotary
 Gas Inj Pool Ext. Air Rotary
 OWWO Expl Wildcat Cable

Ground surface elevation 2960 feet MSL
Domestic well within 330 feet: yes no
Municipal well within one mile: yes no

If OWWO: old well info as follows:
Operator
Well Name
Comp Date Old Total Depth

Depth to bottom of fresh water 180
Depth to bottom of usable water 1600'
Surface pipe by Alternate: 1 2

I certify that well will comply with K.S.A. 55-101, et seq., plus eventually plugging hole to KCC specifications.
Date .. 9-4-86 Signature of Operator or Agent *Don Pratt* Title .. Operator

For KCC Use:
Conductor Pipe Required feet; Minimum Surface Pipe Required 200 feet per Alt. *92*
This Authorization Expires 3-5-87 Approved By 9-5-86 *R. PCA/KCC*

was 250' surface, PCA/KCC

Must be filed with the K.C.C. five (5) days prior to commencing well
This card void if drilling not started within six (6) months of date received by K.C.C.

Important procedures to follow:


1. Notify District office before setting surface casing.
2. Set surface casing by circulating cement to the top.
3. File completion forms ACO-1 with K.C.C. within 90 days of well completion, following instructions on ACO-1; side 1, and including copies of wireline logs.
4. Notify District office 48 hours prior to old well workover or re-entry.
5. Prior to filing Intent, prepare a proposed plugging plan in case well is D & A, then obtain approval of plan when calling district office prior to setting surface pipe.
6. Submit plugging report (CP-4) to K.C.C. after plugging is completed.
7. Obtain an approved injection docket number before disposing of salt water.
8. Notify K.C.C. within 10 days when injection commences or terminates.
9. If an alternate 2 completion, cement in the production pipe from below any usable water to surface within 120 days of spud date.

A Regular Section of Land

1 Mile = 5,280 Ft.

9-5-86

STATE CORPORATION COMMISSION

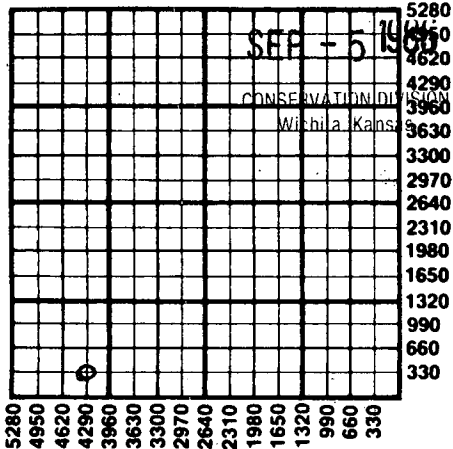

State Corporation Commission of Kansas
Conservation Division
200 Colorado Derby Building
Wichita, Kansas 67202
(316) 263-3238