

CARD MUST BE TYPED

State of Kansas
NOTICE OF INTENTION TO DRILL

CARD MUST BE SIGNED

(see rules on reverse side)

Starting Date: Est 10 1 85
month day year

API Number 15- 179-20,846-00-00

OPERATOR: License # 6114

SE SE SW (location) Sec 31 Twp 10 S, Rge 30 East West

Name DON E. PRATT

Address P. O. BOX 370

City/State/Zip HAYS, KANSAS 67601

Contact Person DON E. PRATT

Phone 913-625-3446

330 Ft North from Southeast Corner of Section
2970 Ft West from Southeast Corner of Section
(Note: Locate well on Section Plat on reverse side)

CONTRACTOR: License # 6033

Name MURFIN DRILLING COMPANY

City/State WHICHITA, KANSAS 67202

Nearest lease or unit boundary line 330 feet.
County SHERIDAN
Lease Name BECKMAN Well# 2-31

Well Drilled For: Well Class: Type Equipment:
 Oil Swd Infield Mud Rotary
 Gas Inj Pool Ext. Air Rotary
 OWWO Expl Wildcat Cable

Domestic well within 330 feet: yes no
Municipal well within one mile: yes no

If OWWO: old well info as follows:
Operator
Well Name
Comp Date Old Total Depth
Projected Total Depth 4250-4350 feet
Projected Formation at TD Cong
Expected Producing Formations L-KC

Depth to Bottom of fresh water 180 feet
Lowest usable water formation Dakota
Depth to Bottom of usable water 2 ~ 1600 feet
Surface pipe by Alternate: 1 2
Surface pipe to be set 250 feet
Conductor pipe if any required none feet
Ground surface elevation Est. 2980 feet MSL
This Authorization Expires 3-12-86
Approved By 9-12-85 [Signature]


I certify that we will comply with K.S.A. 55-101, et seq., plus eventually plugging hole to K.C.C. specifications, cemented to surface at time production casing is set. Production casing will be

Date 9-10-85 Signature of Operator or Agent [Signature] Title Operator

Must be filed with the K.C.C. five (5) days prior to commencing well
This card void if drilling not started within six (6) months of date received by K.C.C.

Important procedures to follow:

**A Regular Section of Land
1 Mile = 5,280 Ft.**

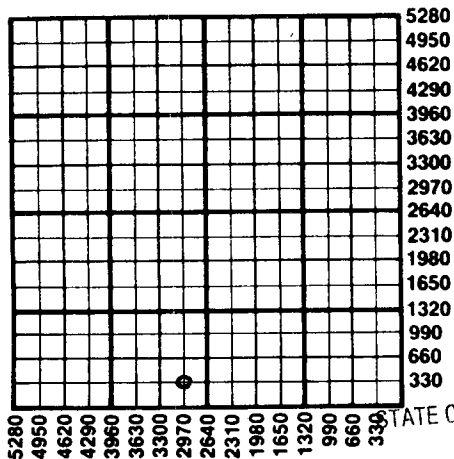

1. Notify District office before setting surface casing.
2. Set surface casing by circulating cement to the top.
3. File completion forms ACO-1 with K.C.C. within 90 days of well completion, following instructions on ACO-1, side 1, and including copies of wireline logs.
4. Notify District office 48 hours prior to old well workover or re-entry.
5. Prior to plugging, prepare a plugging plan, then obtain agreement from the appropriate district office for an approved plugging plan.
6. Submit plugging report (CP-4) to K.C.C. after plugging is completed.
7. Obtain an approved injection docket number before disposing of salt water.
8. Notify K.C.C. within 10 days when injection commences or terminates.

9. If an alternate 2 completion, cement in the production pipe from below any usable water to surface within 120 days of spud date.

RECEIVED
STATE CORPORATION COMMISSION

SEP 12 1985

CONSERVATION DIVISION
Wichita, Kansas

State Corporation Commission of Kansas
Conservation Division
200 Colorado Derby Building
Wichita, Kansas 67202
(316) 263-3238