

STATE CORPORATION COMMISSION OF KANSAS
OIL & GAS CONSERVATION DIVISION

WELL COMPLETION OR RECOMPLETION FORM
ACO-1 WELL HISTORY

DESCRIPTION OF WELL AND LEASE

Operator: License # 8000
Name PANCANADIAN PETROLEUM COMPANY
Address Post Office Box 929
Denver, CO 80201
City/State/Zip

Purchaser

Operator Contact Person James D. Keisling
Phone (303) 825-8371

Contractor: License # 5418
Name Allen Drilling Company

Wellsite Geologist Dan Watterson
Phone (303) 825-8371

Designate Type of Completion
 New Well Re-Entry Workover
 Oil SWD Temp Abd
 Gas Inj Delayed Comp.
 Dry Other (Core, Water Supply etc.)

If OWWO: old well info as follows:
Operator
Well Name
Comp. Date Old Total Depth

WELL HISTORY

Drilling Method:
 Mud Rotary Air Rotary Cable
4/16/86 4/28/86 4/28/86
Spud Date Date Reached TD Completion Date
4,975'
Total Depth PBTD

Amount of Surface Pipe Set and Cemented at 275 feet
Multiple Stage Cementing Collar Used? Yes No
If yes, show depth set feet
If alternate 2 completion, cement circulated from feet depth to w/ SX cmt

API NO. 15-179-20863-00-00
County Sheridan
C SW SW Sec 9 Twp 10 Rge 30 East West

660 Ft North from Southeast Corner of Section
4620 Ft West from Southeast Corner of Section
(Note: Locate well in section plat below)


Lease Name BAALMANN Well # 14-9-#1

Field Name Wildcat

Producing Formation

Elevation: Ground 2922' KB 2927'

Section Plat

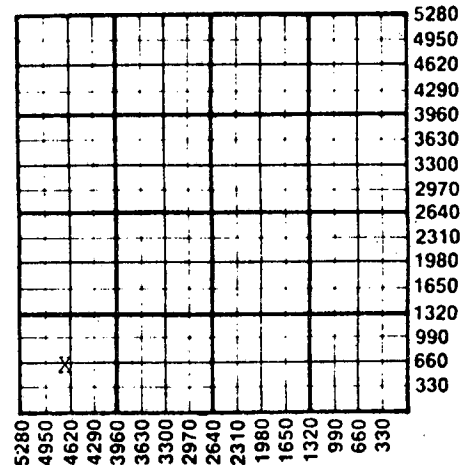

WATER SUPPLY INFORMATION

Disposition of Produced Water: Disposal Repressuring
Docket #

Questions on this portion of the ACO-1 call:
Water Resources Board (913) 296-3717

Source of Water:
Division of Water Resources Permit #

Groundwater 1050 Ft North from Southeast Corner
(Well) 50 Ft West from Southeast Corner of
Sec 8 Twp 10 Rge 30 East West

Surface Water Ft North from Southeast Corner
(Stream, pond etc) Ft West from Southeast Corner
Sec Twp Rge East West

Other (explain) (purchased from city, R.W.D. #)

INSTRUCTIONS: This form shall be completed in duplicate and filed with the Kansas Corporation Commission, 200 Colorado Derby Building, Wichita, Kansas 67202, within 90 days after completion or recompletion of any well. Rule 82-3-130 and 82-3-107 apply. Information on side two of this form will be held confidential for a period of 12 months if requested in writing and submitted with the form. See rule 82-3-107 for confidentiality in excess of 12 months. One copy of all wireline logs and drillers time log shall be attached with this form. Submit CP-4 form with all plugged wells. Submit CP-111 form with all temporarily abandoned wells.

All requirements of the statutes, rules and regulations promulgated to regulate the oil and gas industry have been fully complied with and the statements herein are complete and correct to the best of my knowledge.

Signature James D. Keisling
Title Coord., Eng. Operations U.S. Date 5/20/86

Subscribed and sworn to before me this 20th day of May 1986
Notary Public Barbara Wolf
My Commission Expires February 29, 1988

K.C.C. OFFICE USE ONLY
 Letter of Confidentiality Attached
 Wireline Log Received
 Drillers Timelog Received
Distribution
 KCC SWD/Rep NGPA
 KGS Plug Other (Specify)

STATE CORPORATION COMMISSION
JUN 02 1986
CONSERVATION DIVISION
Wichita, Kansas

Sec. 9, Twp. 10, Rge. 30