


STATE OF KANSAS
STATE CORPORATION COMMISSION

WELL PLUGGING RECORD

Give All Information Completely
Make Required Affidavit
Mail or Deliver Report to:
Conservation Division
State Corporation Commission
800 Bittling Building
Wichita, Kansas

Sheridan County. Sec. 26 Twp. 10 Rge. (E) 28 (W)
Location as "NE/CNWxSWx" or footage from lines NW NW NE
Lease Owner Jones, Shelburne & Farmer, Inc.
Lease Name MADER Well No. 1
Office Address Russell, Kansas
Character of Well (completed as Oil, Gas or Dry Hole) Dry
Date well completed 10-7 1955
Application for plugging filed 10-7 1955
Application for plugging approved 10-7 1955
Plugging commenced 10-7 1955
Plugging completed 10-7 1955
Reason for abandonment of well or producing formation Dry

NORTH

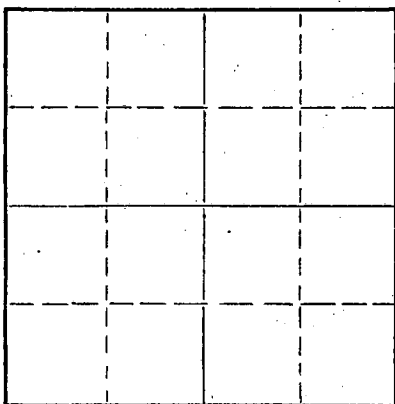

Locate well correctly on above
Section Plat

If a producing well is abandoned, date of last production _____ 19____
Was permission obtained from the Conservation Division or its agents before plugging was commenced? Yes

Name of Conservation Agent who supervised plugging of this well Eldon Petty
Producing formation _____ Depth to top _____ Bottom _____ Total Depth of Well 45.97 Feet
Show depth and thickness of all water, oil and gas formations.

OIL, GAS OR WATER RECORDS

CASING RECORD

FORMATION	CONTENT	FROM	TO	SIZE	PUT IN	PULLED OUT
				8-5/8"	165'	None

Describe in detail the manner in which the well was plugged, indicating where the mud fluid was placed and the method or methods used in introducing it into the hole. If cement or other plugs were used, state the character of same and depth placed, from _____ feet to _____ feet for each plug set.

- Filled hole with heavy mud
- Pushed plug to 160'
- Dumped 1/2 sack hulls on top of plug
- Mixed 15 sacks cement and dumped on top of hulls
- Filled hole to top
- Pushed plug to 40'
- Dumped in 1/2 sack hulls
- Mixed 10 sacks cement and filled hole to top with same.

STATE CORPORATION COMMISSION
10-18-55
OCT 18 1955

Name of Plugging Contractor Jones, Shelburne & Farmer, Inc.
Address Russell, Kansas

STATE OF Kansas COUNTY OF Russell, ss.
JOHN O. FARMER (employee of owner) or (owner or operator) of the above-described well, being first duly sworn on oath, says: That I have knowledge of the facts, statements, and matters herein contained and the log of the above-described well as filed and that the same are true and correct. So help me God.

(Signature) John O. Farmer
Russell, Kansas (Address)

SUBSCRIBED AND SWORN to before me this 17th day of October, 19 55
Lucille Hunsley Notary Public.




PLUGGING
FILE SEC 26 T 10 R 28 W
BOOK PAGE 8 LINE 6

ADDRESS Russell, Kansas

Give detailed description and thickness of all formations drilled through, contents of sand, whether dry, water, oil or gas.

640 Acres
N

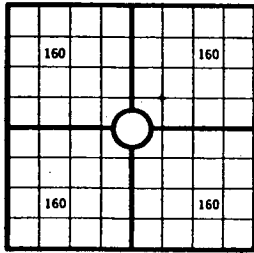

Locate well correctly

COUNTY Sheridan SEC 26 TWP 10 RGE 28
 COMPANY OPERATING Jones, Shelburne & Farmer, Inc.
 OFFICE ADDRESS Russell, Kansas
 FARM NAME Mader WELL NO. 1
 DRILLING STARTED 9-20, 55 DRILLING FINISHED 10-7, 55
 DATE OF FIRST PRODUCTION _____ COMPLETED _____
 WELL LOCATED NW 1/4 NW 1/4 NE 1/4 North of South
 Line and _____ ft. East of West Line of Quarter Section
 Elevation (Relative to sea level) DERRICK FLOOR 2638 GROUND 240 MB
 CHARACTER OF WELL (Oil, gas or dryhole) Dry

Formation	Top	Bottom	Formation	Top	Bottom
Shale	0	165			
Shale & sand	165	1700			
Shale	1700	1860			
Sand	1860	1990			
Shale & shells	1990	2195			
Anhydrite	2195	2230			
Shale & shells	2230	2675			
Lime & shale	2675	4070			
Shale & lime	4070	4105			
Lime & shale	4105	4375			
Lime shale & chert	4375	4410			
Lime & chert	4410	4450			
Lime & shale	4450	4490			
Lime	4490	4513			
Lime shale & chert	4513	4540			
Lime & shale	4540	4597			

TOPS:

Elev 2640
 Heebner 3724
 Toronto 3743
 Lansing 3763
 Base K. C. 4017
 Miss. 4314
 Arbuckle 4524
 T.D. 4597

OIL OR GAS SANDS OR ZONES

Name	From	To	Name	From	To
			4		
			5		
			6		

Corroding Record If Any

Shot Record

Formation	From	To	No. of Shots	Formation	From	To	Size of Shot

CASING RECORD

Amount Set				Amount Pulled				Packer Record			
Size	Wt.	Fths.	Make	Ft.	In.	Ft.	In.	Size	Length	Depth Set	Make
8 5/8				165							

Liner Record: Amount _____ Kind _____ Top _____ Bottom _____

CEMENTING AND MUDDING

Size	Amount Set		Sacks Cement	Chemical		Method of Cementing	Amount	Mudding Method	Results (See Note)
	Ft.	In.		Gal.	Make				
8 5/8	165		115						

Note: What method was used to protect sands if outer strings were pulled? _____

NOTE: Were bottom hole plugs used? _____ If so, state kind, depth set and results obtained _____

TOOLS USED

Rotary Tools were used from _____ feet to _____ Cable tools were used from _____ feet to _____ feet, and from _____ feet to _____ feet, and from _____ feet to _____ feet to _____

Type Rig _____

INITIAL PRODUCTION TEST

Describe initial test—whether by flow through tubing or casing or by pumping _____

Amount of Oil Production _____ bbls. Size of choke, if any _____ Length of test _____ Water

Production _____ bbls. Gravity of oil _____ Type of Pump if pump is used, describe _____

I, the undersigned, being first duly sworn upon oath, state that this well record is true, correct and complete according to the records of this office and to the best of my knowledge and belief.

John D. Farmer Vice-Pres.
 Name and title of representative of company

Subscribed and sworn to before me this 10th day of October, 1955
 My Commission expires July 14, 1958 Bonnie Pratt
 Notary Public.

15-179-00093-00-00
 SEC 26 TWP 10 RGE 28
 COUNTY Sheridan
 WELL NO. 1
 FARM NAME Mader