

STATE OF KANSAS
STATE CORPORATION COMMISSION

Form CP-4


Give All Information Completely
Make Required Affidavit
Mail or Deliver Report to:
Conservation Division
State Corporation Commission
212 No. Market
Wichita, Kansas

WELL PLUGGING RECORD

Sheridan County. Sec. 26 Twp. 10S Rge. 29 (E) W (W)

Location as "NE/CNW/SW" or footage from lines C SW SE
Lease Owner Weaver Oil Company
Lease Name Dege Well No. 1
Office Address 2932 Kerry Lane, Oklahoma City, Oklahoma
Character of Well (completed as Oil, Gas or Dry Hole) Dry hole
Date well completed November 26 19 66
Application for plugging filed November 26 19 66
Application for plugging approved November 26 19 66
Plugging commenced November 26 19 66
Plugging completed November 26 19 66
Reason for abandonment of well or producing formation Dry hole

NORTH

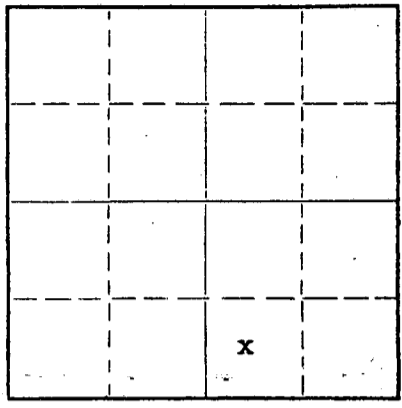

Locate well correctly on above
Section Plat

Name of Conservation Agent who supervised plugging of this well W. L. Nichols, Morland, Kansas
Producing formation _____ Depth to top _____ Bottom _____ Total Depth of Well 4136 Feet
Show depth and thickness of all water, oil and gas formations.


OIL, GAS OR WATER RECORDS

CASING RECORD

FORMATION	CONTENT	FROM	TO	SIZE	PUT IN	PULLED OUT
		0	222	7"	222	0

Describe in detail the manner in which the well was plugged, indicating where the mud fluid was placed and the method or methods used in introducing it into the hole. If cement or other plugs were used, state the character of same and depth placed, from _____ feet to _____ feet for each plug set.

Plugged with heavy mud and hulls and 15 sx cement @ 510';
15 sx cement @ 210'; 10 sx cement @ 40' to surface.

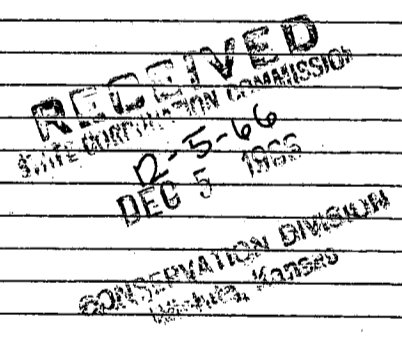

(If additional description is necessary, use BACK of this sheet)

Name of Plugging Contractor Paine Drilling Co., Inc.
Address P. O. Box D, Hill City, Kansas

STATE OF Kansas, COUNTY OF Graham, ss.

FRANK D. F. McCarthy (employee of ~~owner~~ operator) of the above-described well, being first duly sworn on oath, says: That I have knowledge of the facts, statements, and matters herein contained and the log of the above-described well as filed and that the same are true and correct. So help me God.

(Signature) [Signature]
P. O. Box D, Hill City, Kansas
(Address)

SUBSCRIBED AND SWORN TO before me this 30th day of November, 19 66

My commission expires January 20, 1968

[Signature]
Notary Public.

My commission expires _____

CONTRACTOR'S WELL LOG

COMPANY:
CONTRACTOR:
WELL:
LOCATION:
COMMENCED:
COMPLETED:

Weaver Oil Company
Paine Drilling Co., Inc.
Deges # 1
C SW SE Section 26-10S-29W
Sheridan County, Kansas
November 17, 1966
November 26, 1966

0	223	Sand & Shale	Elevation: Ground Level	2729'
223	610	Shale	Derrick Floor	2734'
610	2120	Shale & Sand	Kelly Bushing	2736'
2120	2284	Shale		
2284	2320	Anhydrite		
2320	2820	Shale		
2820	3840	Shale & Lime		
3840	4136	Lime & Shale		
4136		Rotary Total Depth		

RECEIVED
NOV 28 1966
CONSERVATION DIVISION
WICHITA, KANSAS

DEC 5 1966

Set 7 inch surface casing @ 222 ft. with 135 sx cement.

Dry & Abandoned

CONSERVATION DIVISION
Wichita, Kansas

We hereby certify that the above is a correct and accurate log of the above mentioned well, as shown on the daily drilling reports.

PAINE DRILLING CO., INC.

BY: R. F. McCarthy

Subscribed and sworn to before me this 30th day of November, 1966.

Notary Public

Carla S. Miller
Notary Public