


15-065 - 00759-00-00

WELL PLUGGING RECORD

Give All Information Completely  
Make Required Affidavit  
Mail or Deliver Report to:  
Conservation Division  
State Corporation Commission  
800 Bitting Building  
Wichita, Kansas

NORTH

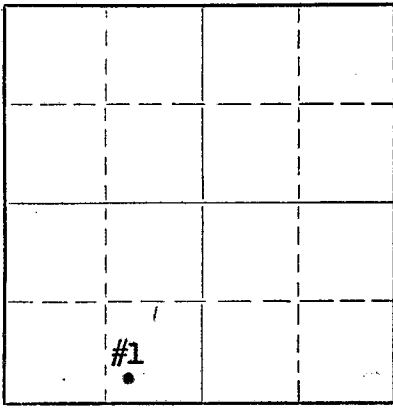

Locate well correctly on above  
Section Plat

Graham County, Sec. 4 Twp. 10S Rge. (E) 23 (W)  
Location as "NE/CNW/SW" or footage from lines SW/4 of SE/4 of SW/4  
Lease Owner Amerada Petroleum Corporation  
Lease Name C. E. Law Well No. 1  
Office Address Box 197 - Great Bend, Kansas  
Character of Well (completed as Oil, Gas or Dry Hole) Dry Hole  
Date well completed July 18, 1955  
Application for plugging filed July 19, 1955  
Application for plugging approved July 19, 1955  
Plugging commenced July 19, 1955  
Plugging completed July 19, 1955  
Reason for abandonment of well or producing formation Dry Hole

If a producing well is abandoned, date of last production 19\_\_\_\_  
Was permission obtained from the Conservation Division or its agents before plugging was commenced? Yes

Name of Conservation Agent who supervised plugging of this well Mr. Eldon Petty of Hays, Kans.  
Producing formation \_\_\_\_\_ Depth to top \_\_\_\_\_ Bottom \_\_\_\_\_ Total Depth of Well 3970' Feet  
Show depth and thickness of all water, oil and gas formations.

OIL, GAS OR WATER RECORDS

CASING RECORD

FORMATION	CONTENT	FROM	TO	SIZE	PUT IN	PULLED OUT
				8-5/8"	1749'	None.

Describe in detail the manner in which the well was plugged, indicating where the mud fluid was placed and the method or methods used in introducing it into the hole. If cement or other plugs were used, state the character of same and depth placed, from \_\_\_\_\_ feet to \_\_\_\_\_ feet for each plug set.

Hole full of heavy mud to 300' from top - set bridge plug & 1/2 sack hulls at 300' - spotted 20 sacks reg. cement thru drill pipe - filled hole with hvy. mud to 40' from top - set bridge plug & 1/2 sack hulls at 40' from top - mixed & dumped in 10 sacks cement filling surface casing to top. Well Plugged & abandoned 7-19-55 as required by State Plugger Mr. Eldon Petty of Hays, Kans.

STATE CORPORATION COMMISSION  
JUL 27 1955  
07-23-1955  
CONSERVATION DIVISION  
WICHITA, KANSAS

(If additional description is necessary, use BACK of this sheet)  
Name of Plugging Contractor Barbour Drilling Co.  
Address Tulsa, Oklahoma.

STATE OF Kansas, COUNTY OF Barton, ss.  
R. A. Drake (employee of owner) or (owner or operator) of the above-described

well, being first duly sworn on oath, says: That I have knowledge of the facts, statements, and matters herein contained and the log of the above-described well as filed and that the same are true and correct. So help me God.

(Signature) R. A. Drake  
Box 197 - Great Bend, Kans.  
(Address)

SUBSCRIBED AND SWORN to before me this 22 day of July, 1955  
Fair E. Stinson  
Notary Public.



PLUGGING  
FILE SEC 4 T 10 R 23W  
BOOK PAGE 36 LINE 15

15-065-00759-00-00

WELL LOG

C. E. LAW No. 1 - SW/4 SE/4 SW/4 - SEC. 4 - 10S - 23W  
GRAHAM COUNTY, KANSAS.

0'	400'	Sand
400'	495'	Shale & Sand
495'	960'	Shale & Shells
960'	1350'	Shale & Sand
1350'	1365'	Shale
1365'	1465'	Red Bed
1465'	1540'	Red Bed & Shale
1540'	1750'	Sand & Red Bed
1750'	2000'	Red Bed
2000'	2065'	Anhydrite
2065'	2525'	Shale & Shells
2525'	2730'	Shale & Lime
2730'	2835'	Lime
2835'	2930'	Shale & Lime
2930'	3095'	Shale
3095'	3355'	Shale & Lime
3355'	3425'	Lime
3425'	3588'	Shale & Lime
3588'	3640'	Lime
3640'	3737'	Lime & Shale
3737'	3791'	Lime & Chert
3791'	3970'	Lime.

**RECEIVED**  
STATE CORPORATION COMMISSION  
JUL 23 1955  
07-23-1955  
CONSERVATION DIVISION  
Wichita, Kansas

**PLUGGING**  
FILE SEC 4 T 10 R 23W  
BOOK PAGE 136 LINE 15