


15-065-30306-00-00

WELL PLUGGING RECORD

Give All Information Completely
Make Required Affidavit
Mail or Deliver Report to:
Conservation Division
State Corporation Commission
212 North Market, Insurance Bldg.
Wichita, Kansas

GRAHAM County. Sec. 4 Twp. 10 Rge. 23 (E) W (W)
Location as "NE/CNW/SW" or footage from lines NE NW NW
Lease Owner MOBLE C. HOOVER
Lease Name LAW Well No. 1
Office Address 110 W. ELM ST., EL DORADO, ARKANSAS
Character of Well (completed as Oil, Gas or Dry Hole) DRY HOLE
Date well completed OCTOBER 8 19 64
Application for plugging filed OCTOBER 8 19 64
Application for plugging approved OCTOBER 8 19 64
Plugging commenced 10:00 A.M. OCTOBER 8 19 64
Plugging completed 11:30 A.M. OCTOBER 8 19 64
Reason for abandonment of well or producing formation DRY HOLE

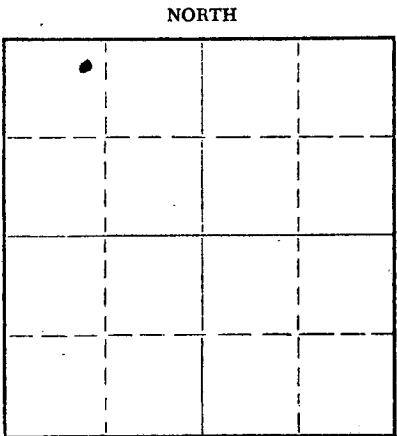

Locate well correctly on above Section Plat

If a producing well is abandoned, date of last production 19
Was permission obtained from the Conservation Division or its agents before plugging was commenced? YES

Name of Conservation Agent who supervised plugging of this well W. L. NICHOLS, MORLAND, KANSAS
Producing formation _____ Depth to top _____ Bottom _____ Total Depth of Well 4020 Feet
Show depth and thickness of all water, oil and gas formations.

OIL, GAS OR WATER RECORDS

CASING RECORD

FORMATION	CONTENT	FROM	TO	SIZE	PUT IN	PULLED OUT
		0	221	7"	221	0

Describe in detail the manner in which the well was plugged, indicating where the mud fluid was placed and the method or methods used in introducing it into the hole. If cement or other plugs were used, state the character of same and depth placed, from _____ feet to _____ feet for each plug set.

PLUGGED W/10 SACKS CEMENT @ 540',
15 SACKS CEMENT @ 210', 10 SACKS
CEMENT @ 30' TO SURFACE; 2 SACKS
CEMENT IN RATHOLE

RECEIVED
STATE CORPORATION COMMISSION
OCT 16 1964
10-16-1964
CONSERVATION DIVISION
Wichita, Kansas

(If additional description is necessary, use BACK of this sheet)
Name of Plugging Contractor CHEMICAL & TECHNICAL SERVICES, INC.
Address P.O. BOX D, HILL CITY, KANSAS

STATE OF KANSAS, COUNTY OF GRAHAM, ss.

(employee of ~~owner~~ or ~~operator~~) of the above-described well, being first duly sworn on oath, says: That I have knowledge of the facts, statements, and matters herein contained and the log of the above-described well as filed and that the same are true and correct. So help me God.

(Signature) Donald Law
P.O. BOX D, HILL CITY, KANSAS (Address)

SUBSCRIBED AND SWORN TO before me this 15 day of October, 1964

My commission expires May 25-1968

Notary Public.

15-065 - 30306-00-00

CONTRACTOR'S WELL LOG

CONTRACTOR:	CHEMICAL & TECHNICAL SERVICES, INC.
OWNER:	MOBLE C. HOOVER
WELL:	LAW #1
LOCATION:	NE NW NW SEC. 4-10S-23W GRAHAM CO., KANSAS
COMMENCED:	9/28/64
COMPLETED:	10/8/64

0	45	CLAY & SAND	ELEVATION: KELLY BUSHING	2479'
45	160	SAND	DERRICK FLOOR	2477'
160	221	SHALE	GROUND LEVEL	2472'
221	440	SHALE & SAND		
440	1445	SHALE, SAND & RED BED		
1445	1615	SHALE & SAND		
1615	1815	SAND		
1815	2069	RED BED & SHALE		
2069	2100	ANHYDRITE		
2100	2360	SHALE		
2360	3760	SHALE & LIME		
3760	4020	LIME		
4020		ROTARY TOTAL DEPTH:		

SET 7" SURFACE CASING @ 221' w/158 SACKS CEMENT

DRY & ABANDONED

WE HEREBY CERTIFY THIS TO BE A CORRECT AND ACCURATE LOG OF THE ABOVE DESCRIBED WELL, AS SHOWN ON THE DAILY DRILLING REPORTS.

CHEMICAL & TECHNICAL SERVICES, INC.

BY: *D. J. McCarthy*
ASST. TREASURER

SUBSCRIBED AND SWORN TO BEFORE THIS 15 DAY OF OCTOBER, 1964.

Notary Public Expires May 25, 1968

Donall Law
NOTARY PUBLIC

RECEIVED
STATE CORPORATION COMMISSION
OCT 16 1964
10-16-1964
CONSERVATION DIVISION
Wichita, Kansas