

WELL PLUGGING RECORD

Give All Information Completely  
Make Required Affidavit  
Mail or Deliver Report to  
Conservation Division  
State Corporation Comm.  
245 North Water  
Wichita, KS 67202

Rooks County Sec. 25 Twp. 9 Rge. 19 EXW  
Location as "NE/CNW/SW" or footage from lines  
SE-NW-SW

Lease Owner Liberty Enterprises Inc.

Lease Name Bartlett Well No. 1

Office Address 308 West Mill Plainville, Kansas 67663

Character of Well (Completed as Oil, Gas or Dry Hole)  
Dry Hole

Date Well completed November 27, 1980 19

Application for plugging filed November 27, 1980 19

Application for plugging approved November 27, 1980 19

Plugging commenced November 27, 1980 4:00 P.M. 19

Plugging completed November 27, 1980 5:30 P.M. 19

Reason for abandonment of well or producing formation  
No commercial Production


If a producing well is abandoned, date of last production  
19

Was permission obtained from the Conservation Division or  
its agents before plugging was commenced? Yes

Name of Conservation Agent who supervised plugging of this well Marion Schmidt

Producing formation \_\_\_\_\_ Depth to top \_\_\_\_\_ Bottom \_\_\_\_\_ Tl. Depth of Well \_\_\_\_\_

Show depth and thickness of all water, oil and gas formations.

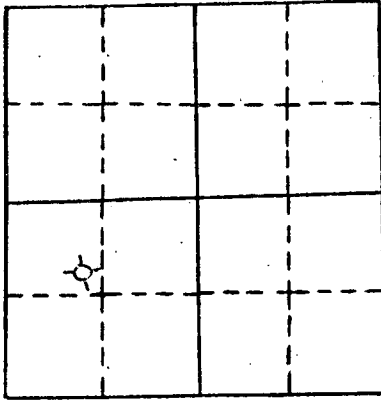

locate well correctly  
on above  
Section Plot

OIL, GAS OR WATER RECORDS

CASING RECORD

FORMATION	CONTENT	FROM	TO	SIZE	PUT IN	PULLED OUT
surface casing	common	0'	248.15	8 5/8	248.15	0'

Describe in detail the manner in which the well was plugged, indicating where the mud fluid was placed and the method or methods used in introducing it into the hold. If cement or other plugs were used, state the character of same and depth placed, from \_\_\_\_\_ feet to \_\_\_\_\_ feet for each plug set.

Plug #1 @ 780' with 70 sxs

Plug #2 @ 180' with 25 sxs

Plug #3 @ 40' with 10 sxs

5 sxs in rathole

50-50-poz 6% gel

Plug down at 5:30 P.M.

RECEIVED  
STATE CORPORATION COMMISSION  
FEB 27 1981  
2781  
CONSERVATION DIVISION  
Wichita, Kansas

(If additional description is necessary, use BACK of this sheet)

Name of Plugging Contractor Pioneer Drilling Company Inc.  
308 West Mill Plainville, Kansas 67663

STATE OF Kansas COUNTY OF Rooks, ss.


Liberty Enterprises, Inc. (employee of owner) or (owner or operator) of the above described well, being first duly sworn on oath, says: That I have knowledge of the facts, statements, and matters herein contained and the log of the above described well is filed and that the same are true and correct. So help me God.

(Signature) Ryan L Green

(Address) 308 W Mill Plainville, Ks. 67663

SUBSCRIBED AND SWORN TO before me this 26<sup>th</sup> day of February, 1981

My commission expires

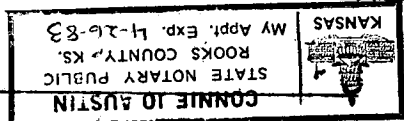

Connie Jo Austin  
Notary Public

15-163-20992-00-00

WELL LOG

OPERATOR: Liberty Enterprises Inc.

WELL NAME: Bartlett #1 LOCATION: 25-9s-19W SE NW SW

COUNTY: Rooks STATE: Kansas

WELL COMMENCED: November 15, 1980 WELL COMPLETED: November 27, 1980

ELEVATION: 2193' G.L. TOTAL DEPTH: 3690'

PRODUCTION: Dry Hole RIG NO: #4

CASING - 8 5/8": 28# used cemented with 90 sxs common 3% cc 2% gel cement did circ

5 1/2": NONE

ALL MEASUREMENTS TAKEN FROM THE TOP OF ROTARY BUSHING:

FROM	TO	FORMATION	DEVIATION FROM VERTICAL	REMARKS:
0'	183'			
183'	209'			
209'	504'			
504'	1050'	shale		
1050'	1247'			
1247'	1446'	shale and sand		
1446'	1554'	shale		
1554'	1583'	anhydrite		
1583'	1589'	shale	1589' 2 1/2 degree	
1589'	1814'	shale		
1814'	2045'	shale		
2045'	2270'	shale		
2270'	2458'	shale		
2458'	2653'	shale		
2653'	2852'	shale		
2852'	2950'	shale		
2950'	3041'	shale and lime		
3041'	3060'	shale and lime		
3060'	3224'	shale and lime		
3224'	3326'	shale and lime		
3326'	3381'	shale and lime		
3381'	3409'	lime	3409' 3/4, degree	
3409'	3470'	lime		
3470'	3510'	shale and lime		
3510'	3564'	lime		
3564'	3595'			
3595'	3631'	lime or chert		
3631'	3690'	ar buckle		
3690'				

RECEIVED  
STATE CORPORATION COMMISSION

FEB 27 1981

CONSERVATION DIVISION  
Wichita, Kansas

STATE OF KANSAS  
COUNTY OF

The undersigned hereby certifies that to the best of his knowledge and belief, the above facts are true and correct

PIONEER DRILLING CO., INC.  
By Connie J. Austin

SUBSCRIBED AND SWORN TO, BEFORE ME, This 27<sup>th</sup> day of February, 1981

Judy Smith  
NOTARY PUBLIC

