


STATE OF KANSAS
STATE CORPORATION COMMISSION

Form CP-4

WELL PLUGGING RECORD

Give All Information Completely
Make Required Affidavit
Mail or Deliver Report to:
Conservation Division
State Corporation Commission
212 No. Market
Wichita, Kansas

NORTH

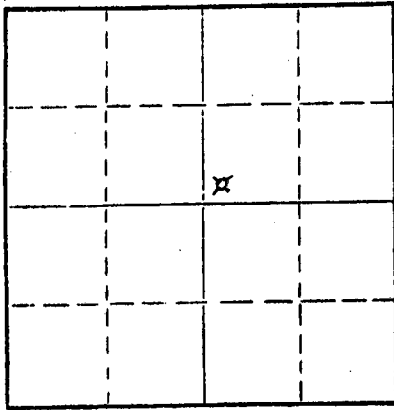

Locate well correctly on above
Section Plat

Sheridan County, Sec. 30 Twp. 10 Rge. 28 ~~NE~~ (W)
Location as "NE/CNW&SW" or footage from lines SW SW NE
Lease Owner Helberg Oil Company
Lease Name Chapman Well No. 2
Office Address Box 32 Morland, Ks. 67650
Character of Well (completed as Oil, Gas or Dry Hole) Dry Hole
Date well completed 1-25 19 83
Application for plugging filed 1-25 19 83
Application for plugging approved 1-25 19 83
Plugging commenced 1-25 19 83
Plugging completed 1-25 19 83
Reason for abandonment of well or producing formation Dry Hole

If a producing well is abandoned, date of last production 19
Was permission obtained from the Conservation Division or its agents before plugging was commenced? Yes

Name of Conservation Agent who supervised plugging of this well
Producing formation Depth to top Bottom Total Depth of Well 4189 Feet
Show depth and thickness of all water, oil and gas formations.

OIL, GAS OR WATER RECORDS

CASING RECORD

FORMATION	CONTENT	FROM	TO	SIZE	PUT IN	PULLED OUT
Surface		0	208	8 5/8"	208	0

Describe in detail the manner in which the well was plugged, indicating where the mud fluid was placed and the method or methods used in introducing it into the hole. If cement or other plugs were used, state the character of same and depth placed, from feet to feet for each plug set.

1st. Plug set at 4000' with 20 sacks common cement 50-50 Poz 6% Gel

2nd. Plug set at 2400' with 20 sacks common cement 50-50 Poz 6% Gel

3rd. Plug set at 1400' with 80 sacks common cement 50-50 Poz 6% Gel

4th Plug set at 220' with 40 sacks common cement 50-50 Poz 6% Gel

5th Plug set at 40' with 10 sacks common cement 50-50 Poz 6% Gel

10 sacks in rathole

Heavy drilling mud between each plug.

(If additional description is necessary, use BACK of this sheet)

Name of Plugging Contractor Sun Oilwell Cementing
Address Oakley, Ks.

STATE OF Kansas COUNTY OF Graham ss.

Jerry M. Helberg (employee of owner) or (owner or operator) of the above-described well, being first duly sworn on oath, says: That I have knowledge of the facts, statements, and matters herein contained and the log of the above-described well as filed and that the same are true and correct. So help me God.

(Signature)

Jerry M. Helberg

Box 32 Morland, Ks. 67650

SUBSCRIBED AND SWORN to before me this 14 day of February

day of February

1983

My commission expires

13-86

RECEIVED
STATE CORPORATION COMMISSION
FEB 16 1983
2-15-83
CONSERVATION DIVISION
Wichita, Kansas

Notary Public.