


WELL PLUGGING RECORD

Give All Information Completely
Make Required Affidavit
Mail or Deliver Report to:
Conservation Division
State Corporation Commission
212 North Market, Insurance Bldg.
Wichita, Kansas

Sheridan County, Sec. 18 Twp. 10S Rge. 26W ~~XX~~ (W)
Location as "NE/CNW/SW" or footage from lines Cent. SE $\frac{1}{4}$ SE $\frac{1}{4}$
Lease Owner Leben Drilling, Inc.
Lease Name Martin Well No. 1
Office Address 905 Central Bldg., Wichita, Kansas.
Character of Well (completed as Oil, Gas or Dry Hole) Dry Hole
Date well completed 3-3-59 19
Application for plugging filed 3-3-59 19
Application for plugging approved 3-3-59 19
Plugging commenced 3-3-59 19
Plugging completed 3-3-59 19
Reason for abandonment of well or producing formation Dry Hole

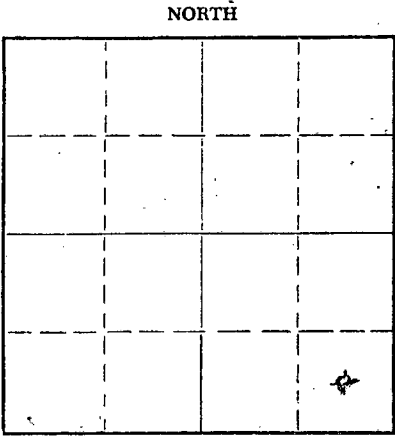

Locate well correctly on above Section Plat

If a producing well is abandoned, date of last production - - 19
Was permission obtained from the Conservation Division or its agents before plugging was commenced? yes

Name of Conservation Agent who supervised plugging of this well Fabricius
Producing formation _____ Depth to top _____ Bottom _____ Total Depth of Well 4460 Feet
Show depth and thickness of all water, oil and gas formations.

OIL, GAS OR WATER RECORDS

CASING RECORD

FORMATION	CONTENT	FROM	TO	SIZE	PUT IN	PULLED OUT
				8 5/8"	211.87	

Describe in detail the manner in which the well was plugged, indicating where the mud fluid was placed and the method or methods used in introducing it into the hole. If cement or other plugs were used, state the character of same and depth placed, from _____ feet to _____ feet for each plug set.
1st plug @ 600' w/20 sacks cement
2nd plug @ 215' w/20 sacks cement
top plug @ 40' w/10 sacks cement.


RECEIVED
STATE CORPORATION COMMISSION
MAR 12 1959
CONSERVATION DIVISION
Wichita, Kansas

(If additional description is necessary, use BACK of this sheet)
Name of Plugging Contractor Leben Drilling, Inc.
Address 905 Central Bldg., Wichita, Kansas

STATE OF Kansas, COUNTY OF Sedgwick, ss.
Frank Hamlin (employee of owner) or (owner or operator) of the above-described well, being first duly sworn on oath, says: That I have knowledge of the facts, statements, and matters herein contained and the log of the above-described well as filed and that the same are true and correct. So help me God.

(Signature) Frank Hamlin
905 Central Bldg., Wichita, Kansas (Address)

SUBSCRIBED AND SWORN to before me this 5th day of March, 19 59
June 17, 1961
Ruth N. Benjamin
Ruth N. Benjamin, Notary Public.

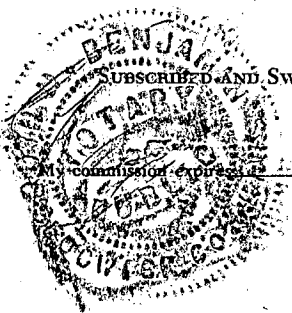

PLUGGING
FILE SEC 18 T 10 R 26W
BOOK PAGE 24 LINE 20

DRILLER'S LOG

COMPANY: **LEBEN DRILLING, INC.**
 CONTRACTOR: **LEBEN DRILLING, INC.**
 FARM: **MARTIN #1**
 LOCATION: **CON. SEC 6E2 SEC. 10-10S-20E**
SHERIDAN COUNTY, KANSAS
 COMMENCED: **FEBRUARY 19, 1959**
 COMPLETED: **MARCH 9, 1959**

0	150	Clay & Sand	TOPS:	
150	210	Shale & Shells	Anhydrite	2250
210	705	Shale, Sand & Shells	Topoko	2605
705	1510	Shale & Shells	Hobner	3029
1510	1750	Shale & Lims	Toronto	3049
1750	1085	Shale & Redbed	Lansing	3079
1805	2250	Redbed	Deno R.C.	4102
2250	2290	Anhydrite	Norman	4137
2290	2490	Shale & Shells	Cherokee	4324
2490	3270	Shale & Lims	Conglomerate	4517
3270	3875	Lims & Shale	Miscosipion	4449
3875	4090	Lims		
4090	4445	Shale & Lims	Elevation	2617 RD
4445	4460	Lims		
4460		<u>Rotary Total Depth - D & A</u>		

Set 211.07 @ 5/8" surface casing @ 210.87 with 165 sacks Sunco cement.

I, Frank Hamlin, do hereby certify that the above and foregoing is a true and correct copy of the log of the Martin #1, located Con. Sec 6E2 of Section 16, Township 10 South, Range 20 West, Sheridan County, Kansas, as reflected by the files of Leben Drilling, Inc.

RECEIVED Frank Hamlin
 STATE COMMISSION
 Frank Hamlin

MAR 12 1959

STATE OF KANSAS)
) SS: CONSERVATION DIVISION
 COUNTY OF SEDGWICK) Wichita, Kansas

Subscribed and sworn to before me, a Notary Public, in and for Sedgewick County, Kansas, this 09th day of March, 1959.

Ruth H. Benjamin
 Ruth H. Benjamin, Notary Public

My commission expires
 June 17, 1961

PLUGGING
 FILE SEC 18 T 10 R 26 W
 BOOK PAGE 24 LINE 20