


STATE OF KANSAS
STATE CORPORATION COMMISSION

Form CP-4

Give All Information Completely
Make Required Affidavit
Mail or Deliver Report to:
Conservation Division
State Corporation Commission
P. O. Box 17027
Wichita, Kansas 67217
NORTH

WELL PLUGGING RECORD

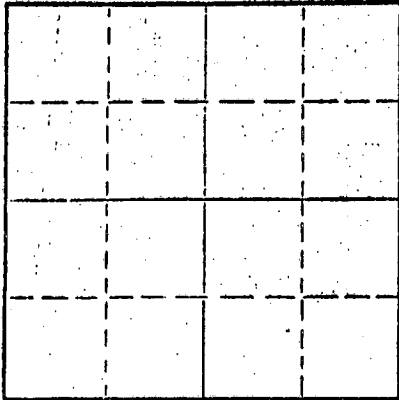

Locate well correctly on above
Section Plat

Sheridan County. Sec. 23 Twp. 10S Rge. 26W (E) (W) X
Location as "NE/CNW/SW" or footage from lines NW NE NW
Lease Owner Hinkle Oil Company
Lease Name McWilliams Well No. 1
Office Address 1016 Union Center, Wichita, Kansas 67202
Character of Well (completed as Oil, Gas or Dry Hole) D&A
Date well completed November 3 19 72
Application for plugging filed November 3 19 72
Application for plugging approved November 3 19 72
Plugging commenced November 3 19 72
Plugging completed November 3 19 72
Reason for abandonment of well or producing formation D&A
If a producing well is abandoned, date of last production 19
Was permission obtained from the Conservation Division or its agents before plugging was commenced? Yes

Name of Conservation Agent who supervised plugging of this well: W. L. Nichols
Producing formation _____ Depth to top _____ Bottom _____ Total Depth of Well 4085 Feet
Show depth and thickness of all water, oil and gas formations.

OIL, GAS OR WATER RECORDS

CASING RECORD

FORMATION	CONTENT	FROM	TO	SIZE	PUT IN	PULLED OUT
				8-5/8"	256.36'	-0-

Describe in detail the manner in which the well was plugged, indicating where the mud fluid was placed and the method or methods used in introducing it into the hole. If cement or other plugs were used, state the character of same and depth placed, from _____ feet to _____ feet for each plug set.

Plugged @ 1275' w/100 sx, plug @ 275' w/30 sx,
plug @ 40' w/10 sx.

RECEIVED
STATE CORPORATION COMMISSION
NOV 20 1972
CONSERVATION DIVISION
Wichita, Kansas

(If additional description is necessary, use BACK of this sheet)

Name of Plugging Contractor Red Tiger Drilling Company
Address 1720 Wichita Plaza, Wichita, Kansas 67202

STATE OF Kansas, COUNTY OF Sedgwick, ss.
Virginia K. Albert (employee of owner) or (owner or operator) of the above-described well, being first duly sworn on oath, says: That I have knowledge of the facts, statements, and matters herein contained and the log of the above-described well as filed and that the same are true and correct. So help me God.

(Signature) Virginia K. Albert
1720 Wichita Plaza, Wichita, Ks. 67202
(Address)

Subscribed and sworn to before me this 7th day of November, 19 72

July 25, 1976.

Barbara L. Dorland

Notary Public.



DRILLERS LOG

No. 1 McWilliams

CASING RECORD:	COMPANY:	Hinkle Oil Company	DESCRIPTION:
8-5/8" @ 256.36'	CONTRACTOR:	Red Tiger Drilling Co.	NW NE NW
w/180 sx cement	COMMENCED:	October 24, 1972	23-10S-26W
TOTAL DEPTH: 4085'	COMPLETED:	November 3, 1972	Sheridan County, Kansas
			ELEVATION:

<u>FORMATION</u>	<u>FROM</u>	<u>TO</u>	<u>REMARKS</u>
Clay - Sand - Shale	0	256	
Shale	256	700	
Sand - Shale	700	1364	
Shale	1364	1690	
Shale - Shells	1690	2135	
Shale - Redbed	2135	2217	
Anhydrite	2217	2252	
Shale - Shells	2252	2420	
Shale - Lime	2420	3555	
Lime	3555	4085	

RECEIVED
STATE CORPORATION COMMISSION
NOV 20 1972
CONSERVATION DIVISION
Wichita, Kansas

I certify that this is a true and correct copy of the above log to the best of my knowledge.

RED TIGER DRILLING COMPANY

Virginia K. Albert

Virginia K. Albert

Subscribed and sworn to before me this 7th day of November, 1972.

Burton L. Dastard

Notary Public

My Commission Expires:
July 25, 1976

