


STATE OF KANSAS  
STATE CORPORATION COMMISSION

WELL PLUGGING RECORD

Give All Information Completely  
Make Required Affidavit  
Mail or Deliver Report to:  
Conservation Division  
State Corporation Commission  
211 No. Broadway  
Wichita, Kansas

Sheridan County. Sec. 14 Twp. 10S Rge. 27 (E) W (W)  
Location as "NE/CNW/SW" or footage from lines SW SW SE  
Lease Owner Anschutz Drilling Co., Inc.  
Lease Name Park College Well No. 1  
Office Address 709 Union National Building: Wichita 2, Kansas  
Character of Well (completed as Oil, Gas or Dry Hole) Dry  
Date well completed September 18 1956  
Application for plugging filed September 18 1956  
Application for plugging approved September 18 1956  
Plugging commenced September 18 1956  
Plugging completed September 18 1956  
Reason for abandonment of well or producing formation Dry

NORTH

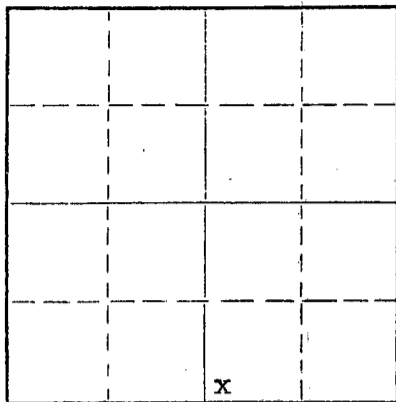

Locate well correctly on above  
Section Plat

If a producing well is abandoned, date of last production 19  
Was permission obtained from the Conservation Division or its agents before plugging was commenced? Yes

Name of Conservation Agent who supervised plugging of this well Eldon Petty  
Producing formation \_\_\_\_\_ Depth to top \_\_\_\_\_ Bottom \_\_\_\_\_ Total Depth of Well 4050 Feet  
Show depth and thickness of all water, oil and gas formations.

OIL, GAS OR WATER RECORDS

CASING RECORD

FORMATION	CONTENT	FROM	TO	SIZE	PUT IN	PULLED OUT
				8 5/8"	190'	

Describe in detail the manner in which the well was plugged, indicating where the mud fluid was placed and the method or methods used in introducing it into the hole. If cement or other plugs were used, state the character of same and depth placed, from \_\_\_\_\_ feet to \_\_\_\_\_ feet for each plug set.


Mud up to 185'. Drove down 1/2 sack hulls. Set Halliburton plug @ 185' with 15 sacks bulk cement. Set second plug at 40' with 10 sacks cement.

(If additional description is necessary, use BACK of this sheet)

Name of Plugging Contractor Kan-Tex Drillers, Inc.  
Address 413 Beacon Building: Wichita 2, Kansas

STATE OF Kansas, COUNTY OF Sedgwick, ss.  
Harvey E. Nightingale (employee of owner) or (owner or operator) of the above-described well, being first duly sworn on oath, says: That I have knowledge of the facts, statements, and matters herein contained and the log of the above-described well as filed and that the same are true and correct. So help me God.

(Signature) Harvey E. Nightingale  
413 Beacon Building, Wichita 2, Kansas (Address)

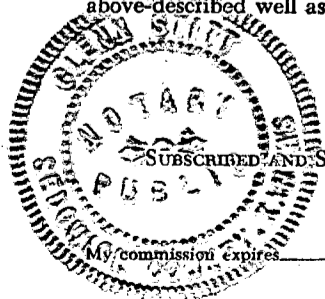

SUBSCRIBED AND SWORN to before me this 20 day of September 1956  
Blum Stitt Notary Public.

PLUGGING  
FILE SEC 14 T. 10 R. 27W  
BOOK PAGE 100 LINE 39

9-28-56  
SEPT 28 1956  
CONSERVATION DIVISION  
Wichita, Kansas

DRILLERS' LOG

No. 1 Park College  
SW SW SE Section 14-10S-27W  
Sheridan County, Kansas

FROM	TO	
0	190	Surface, shale, sand
190	1105	Shale and sand
1105	1135	Shale
1135	1575	Sand
1575	1585	Shale and sand
1585	1821	Shale, shells, sand
1821	1965	Sand
1965	2060	Shale and shells
2060	2174	Red Bed and shale
2174	2215	Anhy.
2215	2565	Shale and shells
2565	2723	Shale and lime
2723	2838	Shale and lime shells
2838	3736	Lime and shale
3736	4050	Lime
	4050	Rotary Total Depth D & A

COMMENCED: 9-7-1956

COMPLETED: 9-17-1956

CASING RECORD:

Set 8 5/8" surface casing  
at 190' with 150 sacks bulk  
cement, 2% Calcium chloride.

K8:2586

STATE OF KANSAS )  
                          ) S S  
COUNTY OF SETPICK )

I hereby affirm that the above and foregoing is a true and correct copy of the formations encountered on the No. 1 Park College, SW SW SE Section 14-10S-27W, Sheridan County, Kansas, as reflected by the daily drilling reports.

KAN-TEX DRILLERS, INC.

By: *Harvey C. Nightingale*  
Harvey C. Nightingale

Subscribed and sworn to before me this 20 day of Sept 1956

*Shirley Stitt*  
Notary Public

My Commission Expires March 16, 1960

PLUGGING  
FILE SEC. 14 T. 10 R. 27W  
BOOK PAGE 109 LINE 39