

STATE OF KANSAS
STATE CORPORATION COMMISSION

WELL PLUGGING RECORD

Give All Information Completely
Make Required Affidavit
Mail or Deliver Report to:
Conservation Division
State Corporation Commission
800 Bitting Building
Wichita, Kansas

Sheridan County. Sec. 19 Twp. 10 Rge. 27 (E) W (W)

Location as "NE/CNW/SW" or footage from lines SE/4 SE/4 NE/4

Lease Owner Prime Drilling Co. & Davis Brothers

Lease Name Falloon Well No. 1

Office Address 1516 Liberty Bank Bldg.

Character of Well (completed as Oil, Gas or Dry Hole) Dry Hole

Date well completed 6-24 19 52

Application for plugging filed 6-24 19 52

Application for plugging approved 6-24 19 52


Plugging commenced 6-24 19 52

Plugging completed 6-24 19 52

Reason for abandonment of well or producing formation _____

If a producing well is abandoned, date of last production _____ 19 _____

Was permission obtained from the Conservation Division or its agents before plugging was commenced? Yes

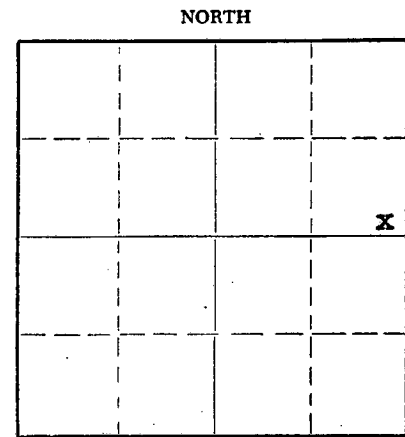

Locate well correctly on above Section Plat

Name of Conservation Agent who supervised plugging of this well Eldon Petty, Hays, Kansas

Producing formation _____ Depth to top _____ Bottom _____ Total Depth of Well 4630 Feet

Show depth and thickness of all water, oil and gas formations.

OIL, GAS OR WATER RECORDS

CASING RECORD

FORMATION	CONTENT	FROM	TO	SIZE	PUT IN	PULLED OUT
				8-5/8	208*	None

Describe in detail the manner in which the well was plugged, indicating where the mud fluid was placed and the method or methods used in introducing it into the hole. If cement or other plugs were used, state the character of same and depth placed, from _____ feet to _____ feet for each plug set.

Filled hole with heavy drilling mud to 200', set plug and cemented with 15 sacks cement. Filled hole with heavy drilling mud to 40', set plug and cemented with 10 sacks cement to bottom of cellar.

(If additional description is necessary, use BACK of this sheet)

Name of Plugging Contractor Prime Drilling Company
Address 1516 liberty Bank Bldg., Oklahoma City, Oklahoma

STATE OF Oklahoma, COUNTY OF Oklahoma, ss.
L. J. Kruse (employee of owner) or (~~owner~~) of the above-described well, being first duly sworn on oath, says: That I have knowledge of the facts, statements, and matters herein contained and the log of the above-described well as filed and that the same are true and correct. So help me God.

(Signature) [Signature]
Oklahoma City, Oklahoma
(Address) 7-2-52
2 1952

RECEIVED
STATE CORPORATION COMMISSION
7-2-52
2 1952

SUBSCRIBED AND SWORN TO before me this 1st day of July, 1952
My commission expires October 24, 1955
[Signature] Notary Public.

PLUGGING
FILE SEC-19710 R276
BOOK PAGE 26 LINE 26

DAVIS BROS. & PRIME DRILLING CO.

FALLOON # 1
SE/4 SE/4 NE/4 Section 19-10S-27W
Sheridan County, Kans.

<u>FORMATION</u>	<u>FROM</u>	<u>TO</u>	<u>REMARKS</u>
Clay & Sand	0	55	8-5/8" C.S.A. @ 209'. Cemented with 150 sacks cement.
Shale & Shale	55	208	
Shale & Shells	208	340	GL: 2654 DF: 2656 KB: 2658
Gray Shale	340	480	
Chalk & Shale	480	560	
Shale & Shells	560	870	
Sand & Shale	870	1260	
Shale & Shells	1260	1440	
Sand & Shale	1440	1495	
Shale Red Bed & Shells	1495	1655	
Shale Shells Red Bed	1655	1760	
Red Bed Shale & Shells	1760	2230	
Anhydrite	2230	2276	
Shale Shell Red Bed	2276	2485	
Shale & Lime	2485	3680	
Lime & Shale	3680	3760	
Lime	3760	4035	
Lime & Shale	4035	4060	
Lime	4060	4110	
Lime & Shale	4110	4360	
Lime & Cherty Shale	4360	4395	
Cherty Lime	4395	4630	
Total Depth		4630'	

I hereby certify the foregoing to be a true and accurate Driller's Log of the formations encountered in the above well.

PRIME DRILLING COMPANY

By: L. J. Kruse
 L. J. Kruse, Secretary

Subscribed and sworn to before me this 30th day of June, 1952.

William Wright
 Notary Public

My Commission Expires: October 24, 1955

RECEIVED
 STATE CORPORATION COMMISSION
 JUL - 2 1952
 CONSERVATION DIVISION
 Wichita, Kansas

PLUGGING
 FILE SEC 19T-10R-27W
 PAGE 26 LINE 26