

Amended

KANSAS CORPORATION COMMISSION
OIL & GAS CONSERVATION DIVISION

ORIGINAL

Form ACO-1
September 1999
Form Must Be Typed

WELL COMPLETION FORM
WELL HISTORY - DESCRIPTION OF WELL & LEASE

Operator: License # 33019
Name: Rosewood Resources, Inc.
Address: 2711 N. Haskell Ave., Suite 2800, LB 22
City/State/Zip: Dallas, TX 75201
Purchaser: _____
Operator Contact Person: Tom Roelfs
Phone: (970) 324-1686
Contractor: Name: Mann Drilling Company
License: n/a
Wellsite Geologist: Steven VonFeldt

Designate Type of Completion:
 New Well Re-Entry Workover
 Oil SWD SLOW Temp. Abd.
 Gas ENHR SIGW
 Dry Other (Core, WSW, Expl., Cathodic, etc)

If Workover/Re-entry: Old Well Info as follows:

Operator: _____
Well Name: _____
Original Comp. Date: _____ Original Total Depth: _____
 Deepening Re-perf. Conv. to Enhr./SWD
 Plug Back Plug Back Total Depth
 Commingled Docket No. _____
 Dual Completion Docket No. _____
 Other (SWD or Enhr.?) Docket No. _____

10/12/2006	11/05/2006	11/06/2006
Spud Date or Recompletion Date	Date Reached TD	Completion Date or Recompletion Date

API No. 15 - 181-20452-04-00
County: Sherman
NW - NE - NE - NW Sec. 11 Twp. 7 S. R. 39 East West
125 feet from S / (circle one) Line of Section
2050 feet from E / (circle one) Line of Section


Footages Calculated from Nearest Outside Section Corner:
(circle one) NE SE NW SW
Lease Name: Yarger Well #: 21-11H
Field Name: Goodland
Producing Formation: Niobrara
Elevation: Ground: 3487' Kelly Bushing: 3494'
Total Depth: 3084' Plug Back Total Depth: 3029'
Amount of Surface Pipe Set and Cemented at 378' KB Feet
Multiple Stage Cementing Collar Used? Yes No
If yes, show depth set _____ Feet
If Alternate II completion, cement circulated from _____
feet depth to _____ w/ _____ sx cmt.

Drilling Fluid Management Plan *N# 6-23-08*
(Data must be collected from the Reserve Pit)
Chloride content 5000 ppm Fluid volume 200 bbls
Dewatering method used Evaporation
Location of fluid disposal if hauled offsite: _____
Operator Name: _____
Lease Name: _____ License No.: _____
Quarter _____ Sec. _____ Twp. _____ S. R. _____ East West
County: _____ Docket No.: _____

INSTRUCTIONS: An original and two copies of this form shall be filed with the Kansas Corporation Commission, 130 S. Market - Room 2078, Wichita, Kansas 67202, within 120 days of the spud date, recompletion, workover or conversion of a well. Rule 82-3-130, 82-3-106 and 82-3-107 apply. Information of side two of this form will be held confidential for a period of 12 months if requested in writing and submitted with the form (see rule 82-3-107 for confidentiality in excess of 12 months). One copy of all wireline logs and geologist well report shall be attached with this form. ALL CEMENTING TICKETS MUST BE ATTACHED. Submit CP-4 form with all plugged wells. Submit CP-111 form with all temporarily abandoned wells.

All requirements of the statutes, rules and regulations promulgated to regulate the oil and gas industry have been fully complied with and the statements herein are complete and correct to the best of my knowledge.

Signature: Gannell Gevel
Title: Production Asst. Date: 2-1-07
Subscribed and sworn to before me this 1 day of February
2007
Notary Public: Kathy Roelfs
Date Commission Expires: 6-3-09

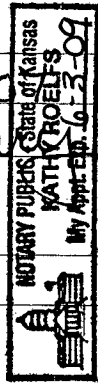

KCC Office Use ONLY

Letter of Confidentiality Received
If Denied, Yes Date: _____
 Wireline Log Received
 Geologist Report Received
 UIC Distribution

RECEIVED
KANSAS CORPORATION COMMISSION
FEB 02 2007

Operator Name: Rosewood Resources, Inc. Lease Name: Yarger Well #: 21-11H
 Sec. 11 Twp. 7 S. R. 39 East West County: Sherman

INSTRUCTIONS: Show important tops and base of formations penetrated. Detail all cores. Report all final copies of drill stems tests giving interval tested, time tool open and closed, flowing and shut-in pressures, whether shut-in pressure reached static level, hydrostatic pressures, bottom hole temperature, fluid recovery, and flow rates if gas to surface test, along with final chart(s). Attach extra sheet if more space is needed. Attach copy of all Electric Wireline Logs surveyed. Attach final geological well site report.

Drill Stem Tests Taken <input type="checkbox"/> Yes <input checked="" type="checkbox"/> No (Attach Additional Sheets) Samples Sent to Geological Survey <input type="checkbox"/> Yes <input checked="" type="checkbox"/> No Cores Taken <input type="checkbox"/> Yes <input checked="" type="checkbox"/> No Electric Log Run <input checked="" type="checkbox"/> Yes <input type="checkbox"/> No (Submit Copy) List All E. Logs Run: GR	<input type="checkbox"/> Log Formation (Top), Depth and Datum <input type="checkbox"/> Sample Name Top Datum Niobrara 944' KB 12
---	--

CASING RECORD <input checked="" type="checkbox"/> New <input type="checkbox"/> Used							
Report all strings set-conductor, surface, intermediate, production, etc.							
Purpose of String	Size Hole Drilled	Size Casing Set (In O.D.)	Weight Lbs. / Ft.	Setting Depth	Type of Cement	# Sacks Used	Type and Percent Additives
Surface	12 1/4"	9 5/8"	32#	378'	Neat	135	
Intermediate	N/A	N/A	N/A	N/A	N/A	N/A	N/A
Production	6 1/4"	4 1/2"	10.5#	3029'	type 1	75	

ADDITIONAL CEMENTING / SQUEEZE RECORD				
Purpose:	Depth Top Bottom	Type of Cement	#Sacks Used	Type and Percent Additives
<input type="checkbox"/> Perforate <input type="checkbox"/> Protect Casing <input type="checkbox"/> Plug Back TD <input type="checkbox"/> Plug Off Zone				

Shots Per Foot	PERFORATION RECORD - Bridge Plugs Set/Type Specify Footage of Each Interval Perforated	Acid, Fracture, Shot, Cement Squeeze Record (Amount and Kind of Material Used)	Depth
4	2925' to 2940'	Frac w/57,987 gals of Mavfoam 70q & 97,770#	
		20/40 RMB sand scf N2	
4	1215' to 1230'	Frac w/53,595 gals of Mavfoam 70q & 97,770#	
		20/40 RMB sand scf N2	

TUBING RECORD	Size	Set At	Packer At	Liner Run <input type="checkbox"/> Yes <input checked="" type="checkbox"/> No
none				

Date of First, Resumerd Production, SWD or Enhr. 12/08/2006	Producing Method <input checked="" type="checkbox"/> Flowing <input type="checkbox"/> Pumping <input type="checkbox"/> Gas Lift <input type="checkbox"/> Other (Explain)
Estimated Production Per 24 Hours	Oil Bbls. n/a Gas Mcf 30 Water Bbls. n/a Gas-Oil Ratio Gravity

Disposition of Gas Vented Sold Used on Lease (If vented, Submit ACO-18.)

METHOD OF COMPLETION Open Hole Perf. Dually Comp. Commingled Other (Specify) _____

Production Interval _____

RECEIVED
KANSAS CORPORATION COMMISSION
FEB 02 2007
CONSERVATION DIVISION
WICHITA, KS

ROSEWOOD RESOURCES INC.

Field: Sherman County, KS
 Site: Yarger 21-11H
 Well: #21-11H
 Wellpath: Lateral






Azimuths to Grid North
 True North: 2.31°
 Magnetic North: 9.92°

Magnetic Field
 Strength: 53499nT
 Dip Angle: 66.97°
 Date: 10/27/2006
 Model: igrf2005



LEGEND
 — #21-11H,Lateral,Plan #1
 — Lateral

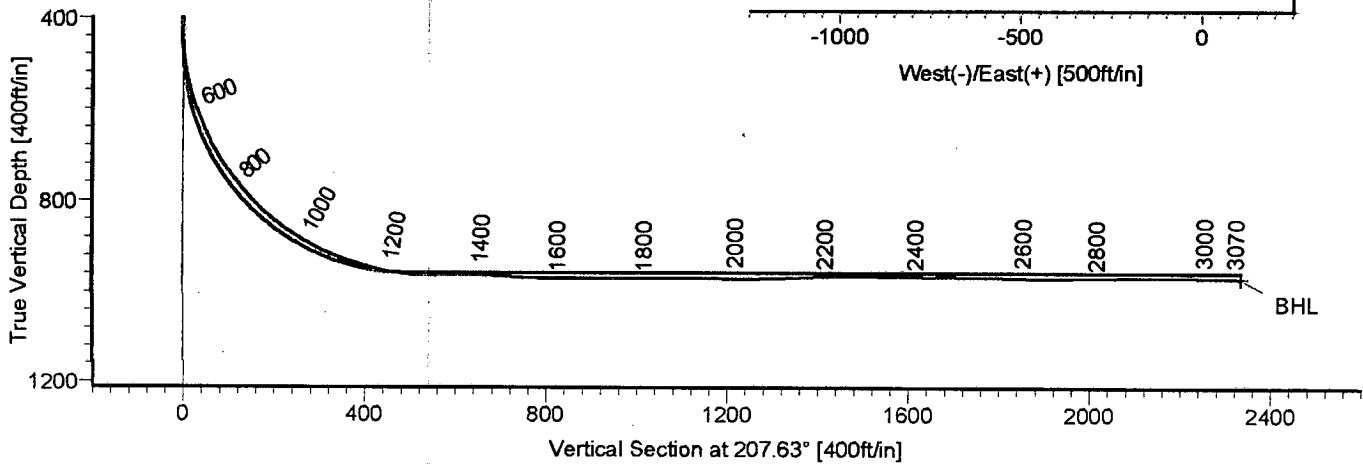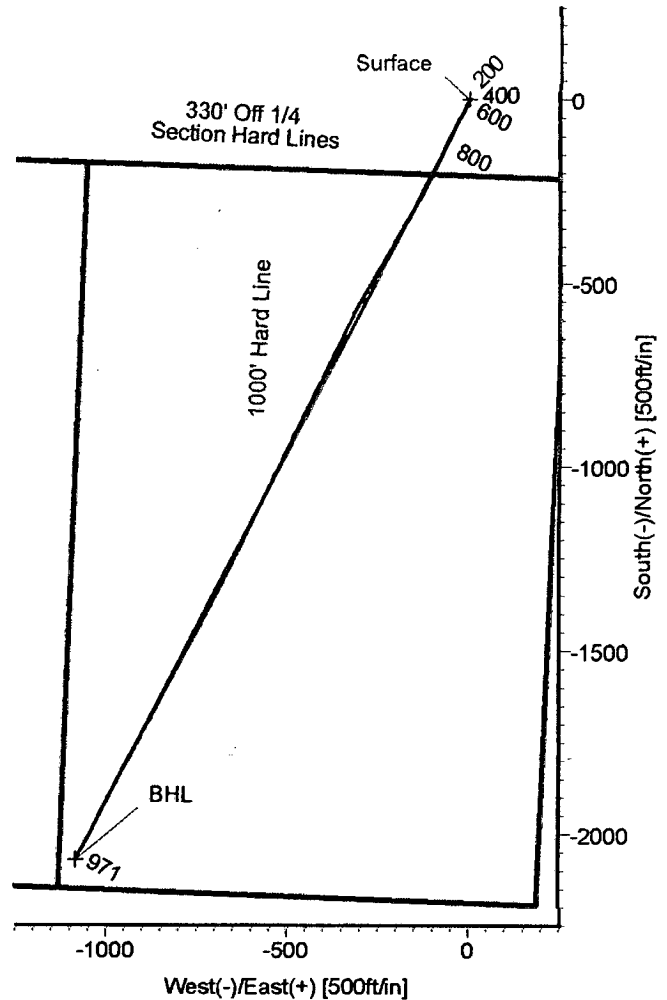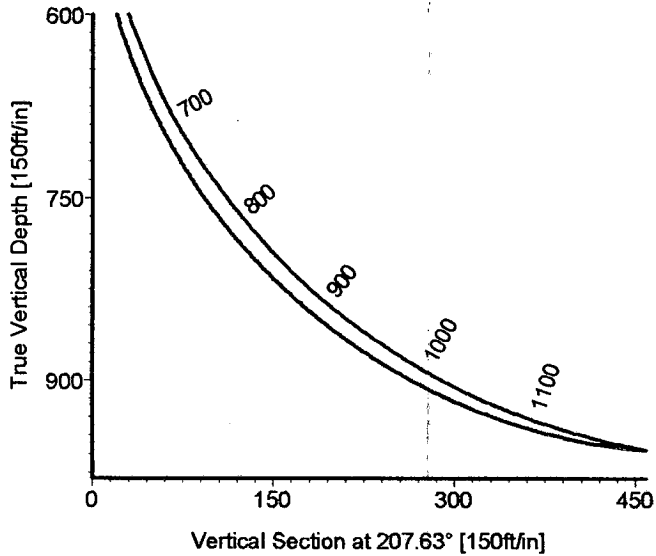

TARGET DETAILS

Name	TVD	+N/-S	+E/-W	Northing	Easting	Latitude	Longitude	Shape
Surface	0.00	0.00	0.00	433572.40	971436.50	39°28'01.048N	101°38'38.958W	Point
BHL	971.17	-2070.59	-1083.76	431501.81	970352.74	39°27'40.169N	101°38'51.703W	Point



STRATA DIRECTIONAL TECHNOLOGY, INC.
 1034 Regional Park Drive Houston, Texas 77060
 Phone: 713-934-9600 Fax: 713-934-9067

Wellpath: (#21-11H/Lateral)
 Created By: David Vogler Date: 11/13/2006
 Checked: _____ Date: _____

Strata Directional Technology, Inc.

Survey Report

Company: ROSEWOOD RESOURCES INC.		Date: 11/13/2006	Time: 13:58:47	Page: 1
Field: Sherman County, KS		Co-ordinate(NE) Reference:	Well: #21-11H, Grid North	
Site: Yarger 21-11H		Vertical (TVD) Reference:	3487+7'KB 3494.0	
Well: #21-11H		Section (VS) Reference:	Well (0.00N,0.00E,207.63Azi)	
Wellpath: Lateral		Survey Calculation Method:	Minimum Curvature	Db: Adapti

Field: Sherman County, KS		
Map System: US State Plane Coordinate System 1927	Map Zone:	Kansas, Northern Zone
Geo Datum: NAD27 (Clarke 1866)	Coordinate System:	Well Centre
Sys Datum: Mean Sea Level	Geomagnetic Model:	igrf2005

Site: Yarger 21-11H		
Site Position:	Northing: 433572.40 ft	Latitude: 39 28 1.048 N
From: Map	Easting: 971436.50 ft	Longitude: 101 38 38.958 W
Position Uncertainty: 0.00 ft		North Reference: Grid
Ground Level: 0.00 ft		Grid Convergence: -2.31 deg

Well: #21-11H		Slot Name:	
Well Position: +N/-S 0.00 ft	Northing: 433572.40 ft	Latitude: 39 28 1.048 N	
+E/-W 0.00 ft	Easting: 971436.50 ft	Longitude: 101 38 38.958 W	
Position Uncertainty: 0.00 ft			

Wellpath: Lateral		Drilled From: Surface	
Current Datum: 3487+7'KB	Height 3494.00 ft	Tie-on Depth: 0.00 ft	
Magnetic Data: 10/27/2006		Above System Datum: Mean Sea Level	
Field Strength: 53499 nT		Declination: 7.62 deg	
Vertical Section: Depth From (TVD)	+N/-S	Mag Dip Angle: 66.97 deg	
ft	ft	ft	Direction deg
0.00	0.00	0.00	207.63

Survey Program for Definitive Wellpath				Version: 0	
Date: 11/13/2006	Validated: No		Toolcode		
Actual From	To	Survey	Tool Name		
ft	ft				
406.00	3020.00	Survey #1 (406.00-3020.00)	MWD	Std MWD	
3070.00	3070.00	Survey #2 (3070.00-3070.00)	Project	Projection	

MD	Incl	Azim	TVD	+N/-S	+E/-W	VS	DLS	Build	Turn	Tool/Comment
ft	deg	deg	ft	ft	ft	ft	deg/100ft	deg/100ft	deg/100ft	
0.00	0.00	0.00	0.00	0.00	0.00	0.00	0.00	0.00	0.00	TIE LINE
406.00	0.70	22.60	405.99	2.29	0.95	-2.47	0.17	0.17	0.00	MWD
428.00	1.30	229.20	427.99	2.25	0.82	-2.37	8.87	2.73	-697.27	MWD
460.00	4.10	217.60	459.95	1.11	-0.16	-0.91	8.87	8.75	-36.25	MWD
492.00	7.50	211.80	491.78	-1.58	-1.96	2.30	10.77	10.62	-18.12	MWD
524.00	11.50	209.90	523.34	-6.12	-4.65	7.58	12.54	12.50	-5.94	MWD
556.00	14.20	208.00	554.53	-12.35	-8.08	14.69	8.54	8.44	-5.94	MWD
587.00	18.90	205.90	584.24	-20.23	-12.06	23.51	15.28	15.16	-6.77	MWD
619.00	22.40	208.20	614.18	-30.27	-17.21	34.80	11.23	10.94	7.19	MWD
651.00	22.40	210.60	643.77	-40.89	-23.19	46.98	2.86	0.00	7.50	MWD
682.00	27.20	208.30	671.90	-52.22	-29.56	59.97	15.79	15.48	-7.42	MWD
714.00	31.60	207.00	699.77	-66.13	-36.84	75.68	13.89	13.75	-4.06	MWD
746.00	35.70	206.20	726.40	-81.99	-44.77	93.40	12.89	12.81	-2.50	MWD
778.00	38.00	206.80	752.01	-99.16	-53.34	112.59	7.27	7.19	7.78	MWD
809.00	40.30	205.90	776.05	-116.70	-62.02	132.15	7.64	7.42	-2.90	MWD
841.00	43.30	206.20	799.90	-135.86	-71.39	153.47	9.40	9.37	0.94	MWD
873.00	47.50	205.10	822.36	-156.40	-81.24	176.24	13.35	13.12	-3.44	MWD
905.00	52.00	205.40	843.04	-178.48	-91.66	200.63	14.08	14.06	0.94	MWD
936.00	54.90	206.50	861.50	-200.87	-102.56	225.52	9.78	9.35	3.55	MWD
968.00	57.70	207.00	879.25	-224.64	-114.54	252.14	8.85	8.75	1.56	MWD
1000.00	61.40	208.80	895.46	-249.01	-127.45	279.72	12.54	11.56	5.62	MWD
1031.00	64.00	209.20	909.68	-273.10	-140.81	307.25	8.47	8.39	1.29	MWD

Strata Directional Technology, Inc.

Survey Report

Company: ROSEWOOD RESOURCES INC.	Date: 11/13/2006	Time: 13:58:47	Page: 2
Field: Sherman County, KS	Co-ordinate(NE) Reference:	Well: #21-11H, Grid North	
Site: Yarger 21-11H	Vertical (TVD) Reference:	3487'+7'KB 3494.0	
Well: #21-11H	Section (VS) Reference:	Well (0.00N,0.00E,207.63Azi)	
Wellpath: Lateral	Survey Calculation Method:	Minimum Curvature	Db: Adapti

Survey

MD ft	Incl deg	Azim deg	TVD ft	+N/-S ft	+E/-W ft	VS ft	DLS deg/100ft	Build deg/100ft	Turn deg/100ft	Tool/Comment
1063.00	68.50	210.40	922.57	-298.50	-155.37	336.52	14.48	14.06	3.75	MWD
1095.00	71.40	210.30	933.54	-324.44	-170.55	366.54	9.07	9.06	-0.31	MWD
1189.00	79.60	209.30	957.05	-403.35	-215.73	457.40	8.78	8.72	-1.06	MWD
1221.00	83.80	210.60	961.67	-430.78	-231.53	489.03	13.73	13.12	4.06	MWD
1253.00	88.30	210.40	963.87	-458.28	-247.73	520.91	14.08	14.06	-0.62	MWD
1285.00	90.80	210.50	964.13	-485.86	-263.95	552.87	7.82	7.81	0.31	MWD
1316.00	90.90	211.60	963.67	-512.42	-279.94	583.81	3.56	0.32	3.55	MWD
1348.00	90.70	210.10	963.22	-539.89	-296.34	615.75	4.73	-0.62	-4.69	MWD
1380.00	88.60	207.70	963.41	-567.90	-311.81	647.74	9.97	-6.56	-7.50	MWD
1412.00	86.40	205.80	964.81	-596.44	-326.19	679.70	9.08	-6.87	-5.94	MWD
1443.00	85.80	206.10	966.92	-624.25	-339.73	710.62	2.16	-1.94	0.97	MWD
1507.00	88.00	206.80	970.38	-681.47	-368.19	774.50	3.61	3.44	1.09	MWD
1539.00	89.40	206.30	971.11	-710.08	-382.49	806.49	4.65	4.37	-1.56	MWD
1634.00	90.40	206.80	971.27	-795.06	-424.95	901.47	1.18	1.05	0.53	MWD
1730.00	89.50	206.00	971.35	-881.05	-467.64	997.45	1.25	-0.94	-0.83	MWD
1825.00	90.30	206.20	971.52	-966.36	-509.43	1092.41	0.87	0.84	0.21	MWD
1921.00	89.20	206.30	971.94	-1052.46	-551.89	1188.38	1.15	-1.15	0.10	MWD
2016.00	90.90	206.00	971.86	-1137.73	-593.76	1283.35	1.82	1.79	-0.32	MWD
2112.00	93.00	206.10	968.59	-1223.93	-635.89	1379.25	2.19	2.19	0.10	MWD
2208.00	89.90	207.10	966.16	-1309.73	-678.85	1475.19	3.39	-3.23	1.04	MWD
2303.00	88.80	208.00	967.24	-1393.95	-722.79	1570.18	1.50	-1.16	0.95	MWD
2398.00	90.30	209.10	967.99	-1477.39	-768.19	1665.16	1.96	1.58	1.16	MWD
2493.00	88.90	207.90	968.65	-1560.87	-813.52	1760.15	1.94	-1.47	-1.26	MWD
2589.00	88.90	208.20	970.49	-1645.58	-858.65	1856.12	0.31	0.00	0.31	MWD
2684.00	90.70	207.70	970.82	-1729.49	-903.18	1951.12	1.97	1.89	-0.53	MWD
2780.00	90.80	208.70	969.57	-1814.09	-948.54	2047.10	1.05	0.10	1.04	MWD
2873.00	90.20	207.50	968.75	-1896.12	-992.34	2140.10	1.44	-0.65	-1.29	MWD
2969.00	89.20	207.30	969.26	-1981.35	-1036.51	2236.09	1.06	-1.04	-0.21	MWD
3020.00	88.80	208.10	970.15	-2026.50	-1060.22	2287.08	1.75	-0.78	1.57	MWD
3070.00	88.80	208.10	971.19	-2070.59	-1083.76	2337.07	0.00	0.00	0.00	PROJECTED to TD

Targets

Name	Description		TVD ft	+N/-S ft	+E/-W ft	Map Northing ft	Map Easting ft	←--- Latitude ---→			←--- Longitude ---→		
	Dip.	Dir.						Deg	Min	Sec	Deg	Min	Sec
Surface			0.00	0.00	0.00	433572.40	971436.50	39	28	1.048 N	101	38	38.958 W
BHL			971.17	-2070.59	-1083.76	431501.81	970352.74	39	27	40.169 N	101	38	51.703 W