


15-193-20060-0000

STATE OF KANSAS  
STATE CORPORATION COMMISSION

WELL PLUGGING RECORD

See All Information Completely  
Make Required Affidavit  
File or Deliver Report to:  
Conservation Division  
State Corporation Commission  
212 No. Market  
Wichita, Kansas 67202

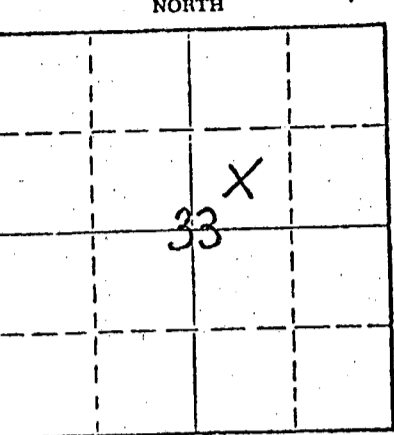

Thomas County, Sec. 33 Twp. 10S Rge. 31 (W)

Location as "NE/CNW&SW4" or footage from lines C SW NE  
Lease Owner Abercrombie Drilling, Inc.  
Lease Name MILLER ESTATE Well No. #1  
Office Address 801 Union Center, Wichita, Kans.  
Character of Well (completed as Oil, Gas or Dry Hole) Dry Hole  
Date well completed September 22, 19 75  
Application for plugging filed September 22, 19 75  
Application for plugging approved September 22, 19 75  
Plugging commenced September 22, 19 75  
Plugging completed September 22, 19 75  
Reason for abandonment of well or producing formation of oil or gas encountered. No commercial quantity

If a producing well is abandoned, date of last production \_\_\_\_\_ 19 \_\_\_\_  
Was permission obtained from the Conservation Division or its agents before plugging was commenced? Yes

Name of Conservation Agent who supervised plugging of this well Gilbert Balthazor  
Producing formation \_\_\_\_\_ Depth to top \_\_\_\_\_ Bottom \_\_\_\_\_ Total Depth of Well 4640 Feet  
Show depth and thickness of all water, oil and gas formations.

OIL, GAS OR WATER RECORDS

CASING RECORD

FORMATION	CONTENT	FROM	TO	SIZE	PUT IN	PULLED OUT
				8 5/8"	200.82	None

Describe in detail the manner in which the well was plugged, indicating where the mud fluid was placed and the method or methods used in introducing it into the hole. If cement or other plugs were used, state the character of same and depth placed, from \_\_\_\_\_ feet to \_\_\_\_\_ feet for each plug set.


1st Plug Set @ 1350' with 70 sx. cement  
2nd Plug Set @ 200' with 20 sx. cement  
3rd Plug Set @ 40' with 10 sx. cement  
Plug was down @ 10:00 a.m. September 22, 1975

RECEIVED  
STATE CORPORATION COMMISSION  
10-31-75  
OCT 31 1975  
CONSERVATION DIVISION  
Wichita, Kansas

(If additional description is necessary, use BACK of this sheet)  
Name of Plugging Contractor Abercrombie Drilling, Inc.  
Address 801 Union Center, Wichita, Kansas 67202

STATE OF KANSAS, COUNTY OF SEDGWICK, ss.  
Jerry A. Langrehr-Exec. V.P. (employee of owner) or (owner or operator) of the above-described well, being first duly sworn on oath, says: That I have knowledge of the facts, statements, and matters herein contained and the log of the above-described well as filed and that the same are true and correct. So help me God.

(Signature) Jerry A. Langrehr  
801 Union Center, Wichita, Kansas 67202  
(Address)

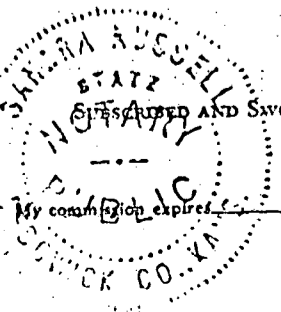

Subscribed and sworn to before me this 23rd day of September, 19 75  
Sandra Russell  
Notary Public.