

STATE OF KANSAS
STATE CORPORATION COMMISSION

15-193-00035-00-00


WELL PLUGGING RECORD

Give All Information Completely
Make Required Affidavit
Mail or Deliver Report to:
Conservation Division
State Corporation Commission
211 No. Broadway
Wichita, Kansas

Thomas County, Sec. 17 Twp. 10 Rge. (E) 36 (W)

Location as "NE/CNW/SW" or footage from lines NW/NW
Lease Owner Excelsior Oil Corporation
Lease Name Marshall Well No. 6
Office Address 300 N. St. Joseph, Hastings, Nebraska
Character of Well (completed as Oil, Gas or Dry Hole) Dry Hole
Date well completed 1-14-59 1959
Application for plugging filed by phone 1-14 1959
Application for plugging approved by phone 1-14 1959
Plugging commenced 12:00 Noon 1-15 1959
Plugging completed 6:00 P.M. 1-15 1959
Reason for abandonment of well or producing formation Non-productive

NORTH

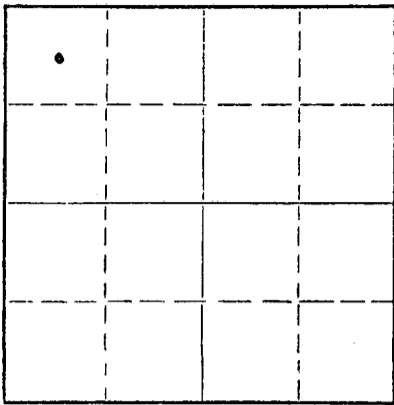

Locate well correctly on above Section Plat

If a producing well is abandoned, date of last production _____ 19____
Was permission obtained from the Conservation Division or its agents before plugging was commenced? Yes

Name of Conservation Agent who supervised plugging of this well Al Fabricus, Hill City, Kansas
Producing formation _____ Depth to top _____ Bottom _____ Total Depth of Well 5487 Feet
Show depth and thickness of all water, oil and gas formations.

OIL, GAS OR WATER RECORDS

CASING RECORD

FORMATION	CONTENT	FROM	TO	SIZE	PUT IN	PULLED OUT
				8-5/8	293	None

Describe in detail the manner in which the well was plugged, indicating where the mud fluid was placed and the method or methods used in introducing it into the hole. If cement or other plugs were used, state the character of same and depth placed, from _____ feet to _____ feet for each plug set.

The hole was full of drilling mud - 66 viscosity, 10cc water loss 9.7# weight.
20 sacks of cement were pumped through the drill pipe at 600 ft. Top of plug 540'. 20 sacks were pumped through the drill pipe at 280'. Top of plug 220'. 10 sacks in top plug, 40 ft. up to 10 ft.

Plugging completed 6:00 P.M., 1-15-59.

RECEIVED
STATE CORPORATION COMMISSION
02-25-1959
FEB 25 1959
CONSERVATION DIVISION
Wichita, Kansas

(If additional description is necessary, use BACK of this sheet)


Name of Plugging Contractor Falcon-Seaboard Drilling Co.
Address Tulsa, Okla.

STATE OF KANSAS, COUNTY OF KEARNY, ss. Lawrence Holmstrom (employee of owner) or (owner) or (operator) of the above-described well, being first duly sworn on oath, says: That I have knowledge of the facts, statements, and matters herein contained and the log of the above-described well as filed and that the same are true and correct. So help me God.

(Signature) Lawrence Holmstrom
Lakin, Kansas (Address)

SUBSCRIBED AND SWORN to before me this 23rd day of February, 1959

Oliver N. Green
Notary Public.

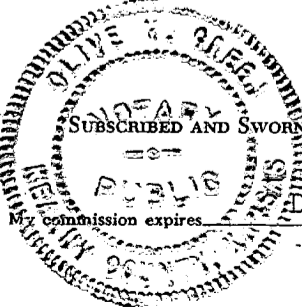

PLUGGING
FILE SEC. 17 T. 10 R. 36W
BOOK PAGE 13 LINE 26