


WELL PLUGGING RECORD

Give All Information Completely  
Make Required Affidavit  
Mail or Deliver Report to:  
Conservation Division  
State Corporation Commission  
800 Biting Building  
Wichita, Kansas

SHERMAN

County. Sec. 7 Twp. 10S Rge. 39W (E) (W)

Location as "NE/CNW $\frac{1}{4}$ SW $\frac{1}{4}$ " or footage from lines SW $\frac{1}{4}$ , SE $\frac{1}{4}$ , SW $\frac{1}{4}$   
Lease Owner Phillips Petroleum Company  
Lease Name A. R. Tompkins Well No. 1  
Office Address Bartlesville, Oklahoma  
Character of Well (completed as Oil, Gas or Dry Hole) Dry Hole  
Date well completed August 30, 1957  
Application for plugging filed 19  
Application for plugging approved 19  
Plugging commenced August 30, 1957  
Plugging completed August 30, 1957  
Reason for abandonment of well or producing formation Dry Hole

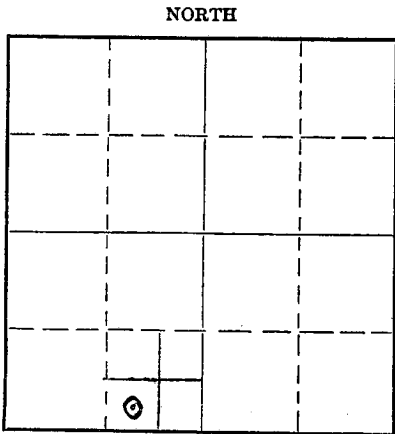

Locate well correctly on above Section Plat

If a producing well is abandoned, date of last production 19  
Was permission obtained from the Conservation Division or its agents before plugging was commenced? Yes

Name of Conservation Agent who supervised plugging of this well  
Producing formation Depth to top Bottom Total Depth of Well 5801' Feet  
Show depth and thickness of all water, oil and gas formations.


OIL, GAS OR WATER RECORDS

CASING RECORD

Formation	Content	From	To	Size	Put In	Pulled Out

Describe in detail the manner in which the well was plugged, indicating where the mud fluid was placed and the method or methods used in introducing it into the hole. If cement or other plugs were used, state the character of same and depth placed, from feet to feet for each plug set.

Run in hole to 3030 Ft.  
Gun pits and circulate heavy mud.  
Run 15 sacks of cement ( 3030' to 2980' )  
( This would be a 50 Ft. plug from 20 Feet in the Anhydrite to 30 feet in the red shale. )  
Come up the hole to 181 feet and run 30 sacks of cement. ( This would be a 100 Ft. plug: 181 Ft. to 81 Ft. or 50 Ft. into the casing. )  
Come up the hole to one 30 Ft. joint set in the slips and run 6 sacks of cement.  
( This would be a 19 Ft. plug at the surface. )

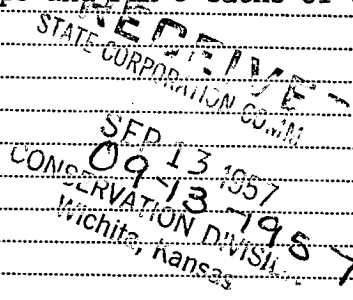

(If additional description is necessary, use BACK of this sheet)

Correspondence regarding this well should be addressed to

Address

STATE OF Kansas, COUNTY OF Sherman, ss.

(employee of owner) or (owner or operator) of the above-described well, being first duly sworn on oath, says: That I have knowledge of the facts, statements, and matters herein contained and the log of the above-described well as filed and that the same are true and correct. So help me God.

(Signature) J. L. Smith

P.O. Box 183 Goodland, Kans (Address)

SUBSCRIBED AND SWORN TO before me this 9 day of September, 1957

My commission expires January 10 1959

Hallie Hartley Co. Clerk Notary Public.

PLUGGING  
FILE SEC 7 T 10 R 39W  
BOOK PAGE 43 LINE 29