


WELL PLUGGING RECORD

Give All Information Completely
Make Required Affidavit
Mail or Deliver Report to:
Conservation Division
State Corporation Commission
800 Bitting Building
Wichita, Kansas

NORTH

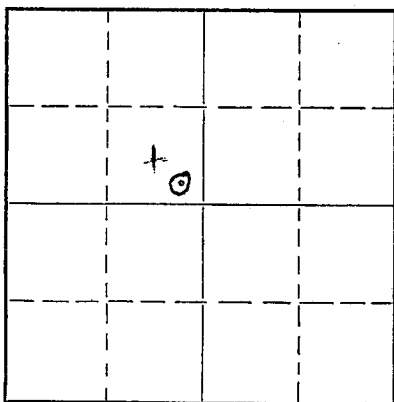

Locate well correctly on above
Section Plat

Sherman County, Sec. 10 Twp. 10S Rge. 39 (E) W (W)
Location as "NE/CNW $\frac{1}{4}$ /SW $\frac{1}{4}$ " or footage from lines Se SE NW
Lease Owner Phillips Petroleum Company
Lease Name Laughlin Well No. #1
Office Address Bartlesville, Oklahoma
Character of Well (completed as Oil, Gas or Dry Hole) Dry Hole
Date well completed 10-12-57
Application for plugging filed 10-11-57
Application for plugging approved 10-21-57
Plugging commenced 10-12-57
Plugging completed 10-12-57
Reason for abandonment of well or producing formation Dry Hole

If a producing well is abandoned, date of last production 19
Was permission obtained from the Conservation Division or its agents before plugging was commenced? Yes

Name of Conservation Agent who supervised plugging of this well Eldon Petty
Producing formation Depth to top Bottom Total Depth of Well Feet
Show depth and thickness of all water, oil and gas formations.

OIL, GAS OR WATER RECORDS

CASING RECORD

Formation	Content	From	To	Size	Put In	Pulled Out
		Surface	199 Ft	8 5/8"		No

Describe in detail the manner in which the well was plugged, indicating where the mud fluid was placed and the method or methods used in introducing it into the hole. If cement or other plugs were used, state the character of same and depth placed, from feet to feet for each plug set.

Run in hole to 3030' : Gun pits and circulate heavy mud.
Run 20 sacks of cement. (This would be a 65 Ft. plug from 30 ft. in the Anhydrite to 35 ft. in the red shale. 3030' to 2965')
Come up the hole to 240 Ft. and run 30 sacks of cement. (This would be a 100 Ft. plug, 240 Ft. to 140 Ft. , or, 45 Ft. below the casing to 55 Ft. in the casing.
Come up the hole and run 10 sacks, 30 Ft. to surface.

RECEIVED
STATE CORPORATION COMMISSION
11-16-1957
NOV 16 1957

(If additional description is necessary, use BACK of this sheet)

CONSERVATION DIVISION
Wichita, Kansas

Correspondence regarding this well should be addressed to L. A. Shutt
Address Goodland, Kansas

STATE OF Kansas, COUNTY OF Sherman, ss.
L. A. Shutt (employee of owner) or (owner or operator) of the above-described well,
being first duly sworn on oath, says: That I have knowledge of the facts, statements, and matters herein contained and the log of the above-described well as filed and that the same are true and correct. So help me God.

(Signature) L. A. Shutt

(Address)

SUBSCRIBED AND SWORN to before me this 13 day of November, 1957

L. H. Savage

Notary Public.

My commission expires February 23, 1959

PLUGGING
FILE SEC 10 T 10 R 39 W
BOOK PAGE 54 LINE 16