


15-181-30014-00-00

WELL PLUGGING RECORD

Give All Information Completely
Make Required Affidavit
Mail or Deliver Report to:
Conservation Division
State Corporation Commission
800 Bitting Building
Wichita, Kansas

SHERMAN (KANSAS) County, Sec. 24 Twp. 10S Rge. 42W (E) (W) W

Location as "NE/CNW/SW" or footage from lines SE SE SE
Lease Owner Van-Grisso Oil Co (Operator) (Superior Oil Corp-lease owner)
Lease Name Levi Golden Well No. 1
Office Address 1012 City National Bldg., Okla City 2, Okla
Character of Well (completed as Oil, Gas or Dry Hole) dry hole
Date well completed July 7 19 56
Application for plugging filed July 7 19 56
Application for plugging approved Field approval July 7 19 56
Plugging commenced July 7 19 56
Plugging completed July 7 19 56
Reason for abandonment of well or producing formation dry hole

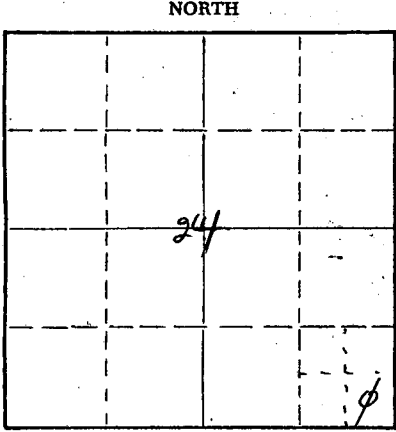

Locate well correctly on above Section Plat

If a producing well is abandoned, date of last production none 19
Was permission obtained from the Conservation Division or its agents before plugging was commenced? yes

Name of Conservation Agent who supervised plugging of this well Eldon Petty, Hayes, Kansas
Producing formation dry hole Depth to top Bottom Total Depth of Well 5471' Feet
Show depth and thickness of all water, oil and gas formations.

OIL, GAS OR WATER RECORDS

CASING RECORD

FORMATION	CONTENT	FROM	TO	SIZE	PUT IN	PULLED OUT
No oil or gas formations	drilled.					
Tertiary water sand zones (Ogallala)		0	222'	8-5/8"	252'	none

Describe in detail the manner in which the well was plugged, indicating where the mud fluid was placed and the method or methods used in introducing it into the hole. If cement or other plugs were used, state the character of same and depth placed, from feet to feet for each plug set.

Filled the hole with heavy mud up to 240' in depth and set wooden plug at 240' with 1/2 sack hulls on top and cemented with 15 sacks cement thru the drill pipe and then filled the hole up with mud to 40' and set the top plug of the same type with a sack of hulls and cemented with 10 sx. cement to top of surface pipe.

RECEIVED
STATE CORPORATION COMMISSION

JUL 21 1956

CONSERVATION DIVISION
Wichita, Kansas

07-21-1956

(COPY OF DRILLERS' LOG IS ATTACHED HERETO.)

(If additional description is necessary, use BACK of this sheet)

Name of Plugging Contractor Nye & Snell Drilling Company (contractor on the well) Denver, Colorado
Address 260 Denver Club Building, Denver, Colorado

STATE OF Oklahoma, COUNTY OF Oklahoma, ss.

I, Don L. Hyatt, Geologist for Van-Grisso Oil Company (employee of owner) or (owner or operator) of the above-described well, being first duly sworn on oath, says: That I have knowledge of the facts, statements, and matters herein contained and the log of the above-described well as filed and that the same are true and correct. So help me God.

(Signature) Don L. Hyatt
Don L. Hyatt
1012 City National Bldg., Okla City 2, Okla
(Address)

SUBSCRIBED AND SWORN TO before me this 19th day of July, 19 56

My commission expires January 7, 1957

Mary Pylant
Notary Public.



PLUGGING
FILE SEC. 24 T. 10 R. 42W
BOOK PAGE 79 LINE 15

15-181-30014-00-00

VAN-GRISSE OIL COMPANY
1012 City National Building
Oklahoma City 2, Oklahoma

GOLDEN WELL #1
SE SE SE Sec. 24-10S-42W
Sherman County, Kansas

FORMATION

Shale and Sand	0	200
Sand and Shale	200	514
Shale	514	1,785
Shale and Sand	1,785	2,810
Lime and Shale	2,810	3,060
Red Bed and Shale	3,060	3,095
Lime and Shale	3,095	4,895
Lime, Sand and Shale	4,895	4,931
Lime and Shale	4,931	5,471

Total Depth 5,471'
Schlumberger T.D. 5,400'

RECEIVED
STATE CORPORATION COMMISSION

JUL 21 1956
07-21-1956
CONSERVATION DIVISION
Wichita, Kansas

I, the undersigned, being first duly sworn upon oath, state that this well record is true, correct and complete according to the records of this office and to the best of my knowledge and belief.

Don L. Hyatt geologist
Name and title of representative of company

Subscribed and sworn to before me this 10th day of July, 1956

My Commission expires

Jan 7-1957

Mary Pylant
Notary Public
MARY PYLANT



PLUGGING
FILE SEC. 24 T10 H2W
BOOK PAGE 79 LINE 15