


WELL PLUGGING RECORD

Give All Information Completely  
Make Required Affidavit  
Mail or Deliver Report to:  
Conservation Division  
State Corporation Commission  
211 No. Broadway  
Wichita, Kansas

Sherman County, Sec. 36 Twp. 10 Rge. 42 (E) (W)  
Location as "NE/CNW/SW" or footage from lines SW SW  
Lease Owner Smith Brothers Oil Co., & Terrel Drilling & Producing  
Lease Name Moore Well No. 1  
Office Address 1005 Union National Bldg., Wichita, Kansas  
Character of Well (completed as Oil, Gas or Dry Hole) Dry hole  
Date well completed 6-24 19 64  
Application for plugging filed 6-24 19 64  
Application for plugging approved 6-24 19 64  
Plugging commenced 6-24 19 64  
Plugging completed 6-24 19 64  
Reason for abandonment of well or producing formation None

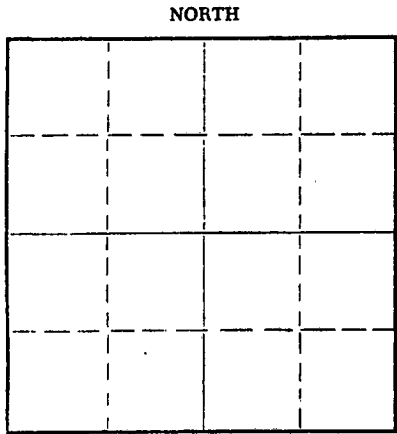

Locate well correctly on above  
Section Plat

If a producing well is abandoned, date of last production 19  
Was permission obtained from the Conservation Division or its agents before plugging was commenced? Yes

Name of Conservation Agent who supervised plugging of this well Bill Nichols  
Producing formation Depth to top Bottom Total Depth of Well 5407 Feet  
Show depth and thickness of all water, oil and gas formations.

OIL, GAS OR WATER RECORDS

CASING RECORD

FORMATION	CONTENT	FROM	TO	SIZE	PUT IN	PULLED OUT
		0	375'	8 5/8	368'	-0-

Describe in detail the manner in which the well was plugged, indicating where the mud fluid was placed and the method or methods used in introducing it into the hole. If cement or other plugs were used, state the character of same and depth placed, from feet to feet for each plug set.

Filled hole with mud to 660', plug, 20 sks. cement.  
Mud to 360', plug, 20 sks. cement.  
Mud to 40', plug, 10 sks. cement.

RECEIVED  
STATE CORPORATION COMMISSION

JUN 29 1964  
06-29-1964  
CONSERVATION DIVISION  
Wichita, Kansas

(If additional description is necessary, use BACK of this sheet)

Name of Plugging Contractor - Terrel Drilling and Producing  
Address Box 606, Russell, Kansas

STATE OF KANSAS, COUNTY OF RUSSELL, ss.  
I, Joe K. Branum (employee of owner) or (owner or operator) of the above-described well, being first duly sworn on oath, says: That I have knowledge of the facts, statements, and matters herein contained and the log of the above-described well as filed and that the same are true and correct. So help me God.

(Signature) Joe K. Branum  
Box 606, Russell, Kansas (Address)

SUBSCRIBED AND SWORN TO before me this 26th day of June, 19 64

My commission expires 12-12-66

L. L. Simpson Notary Public.

15-181-30015-00-00

W E L L L O G

OPERATOR: Smith Brothers Oil Co.  
1005 Union National Bldg,  
Wichita, Kansas and  
Terrel Drilling & Producing

CONTRACTOR: Terrel Drilling and Producing  
Box 506  
Russell, Kansas

LEASE: Moore #1

COMMENCED: May 28, 1964

LOCATION: SW SW, Sec. 36-10-42  
Sherman County, Kansas

COMPLETED: June 24, 1964

DEPTHS & FORMATIONS

Shale	2267	Lime	4250
Shale, Sand & Iron Pyrite	2380	Lime & Shale	4385
Shale & Pyrite	2506	Lime	4525
Anhydrite	2739	Lansing Kansas City Lime	4600
Shale	2920	Lime	4662
Shale & Red Bed	3090	Lime & Shale	4930
Red Bed & Shale	3310	Lime	4950
Shale & Chalk	3455	Lime & Shale	5041
Shale & Lime	3695	Lime	5337
Lime & Shale	3708	Shale & Lime	5384
Shale	3805	Mississippi Lime (R.T.D.)	
Lime & Shale	4175		

RECEIVED  
STATE CORPORATION COMMISSION

JUN 29 1964  
06-29-1964  
CONSERVATION DIVISION  
Wichita, Kansas

STATE OF KANSAS )  
                          )  
COUNTY OF RUSSELL) ss...

Joe K. Branum, owner of Terrel Drilling and Producing, being first duly sworn on oath says: "That I have knowledge of the facts, statements and matters herein contained and the log of the above described well as filed and that the same are true and correct."

Joe K. Branum  
Joe K. Branum - TERREL DRILLING AND PRODUCING

Subscribed and sworn before me this 26th day of June, 1964.

L. Lee Simpson  
Notary Public

My Commission Expires December 12, 1965.