

CARD MUST BE TYPED

State of Kansas

CARD MUST BE SIGNED

NOTICE OF INTENTION TO DRILL

OWWO

(see rules on reverse side)

Expected Spud Date..... 7 month 15 day 88 year

API Number 15— 193-20, 174-0001

OPERATOR: License # 3007
Name Western Kansas Explor./Newport Energy
Address 1220 Forrest St.
City/State/Zip Wichita, KS 67203
Contact Person Scott Woods
Phone (316) 267-1450

C SE NW Sec. 15 Twp. 10S S, Rg. 35W X East
3300 Ft. from South Line of Section
3300 Ft. from East Line of Section

(Note: Locate well on Section Plat on reverse side)

CONTRACTOR: License # 4083
Name Western Kansas Drlg.
City/State Hays, KS

Nearest lease or unit boundary line 660 feet
County Thomas
Lease Name Medford Farms Well # 1

Ground surface elevation 3299 feet MSL
Domestic well within 330 feet: —yes Xno
Municipal well within one mile: —yes Xno

Well Drilled For: Well Class: Type Equipment:
X Oil — Storage — Infield X Mud Rotary
— Gas — Inj — Pool Ext. — Air Rotary
X OWWO — Expl X Wildcat — Cable

Depth to bottom of fresh water 200
Depth to bottom of usable water 1800
Surface pipe by Alternate: 1 — 2 X

If OWWO: old well info as follows:
Operator Donald Slawson
Well Name Medford Farms
Comp Date 10/88 ~~78~~ Old Total Depth 4800

Surface pipe planned to be set N/A - 220 363
Conductor pipe required N/A
Projected Total Depth feet
Formation MISS

I certify that well will comply with K.S.A. 55-101, et seq., plus eventually plugging hole to KCC specifications.

Date 7-14-88 Signature of Operator or Agent [Signature] Title D.P.

For KCC Use:
Conductor Pipe Required feet; Minimum Surface Pipe Required 363 feet per Alt. X (2)
This Authorization Expires 1-14-89 Approved By LKM 7-14-88


EFFECTIVE DATE: 7-19-88

Must be filed with the K.C.C. five (5) days prior to commencing well
 This card void if drilling not started within six (6) months of date received by K.C.C.

Important procedures to follow:

1. Notify District office before setting surface casing.
2. Set surface casing by circulating cement to the top.
3. File completion forms ACO-1 with K.C.C. within 120 days of well spud date, following instructions on ACO-1, side 1, and including copies of wireline logs.
4. Notify District office 48 hours prior to old well workover or re-entry.
5. Prior to filing Intent, prepare a proposed plugging plan in case well is D & A, then obtain approval of plan when calling district office prior to setting surface pipe.
6. Submit plugging report (CP-4) to K.C.C. after plugging is completed.
7. Obtain an approved injection docket number before disposing of salt water.
8. Notify K.C.C. within 10 days when injection commences or terminates.
9. If an alternate 2 completion, cement in the production pipe from below any usable water to surface within 120 days of spud date.

**A Regular Section of Land
 1 Mile = 5,280 Ft.**

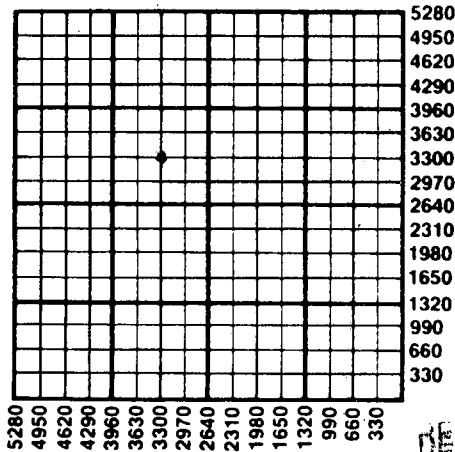

RECEIVED
 STATE CORPORATION COMMISSION
 STATE CORPORATION

JUL 14 1988
 07-14-1988
 CONSERVATION DIVISION
 Wichita, Kansas

State Corporation Commission of Kansas
 Conservation Division
 200 Colorado Derby Building
 Wichita, Kansas 67202-1212
 (316) 263-3238