

STATE CORPORATION COMMISSION OF KANSAS  
OIL & GAS CONSERVATION DIVISION  
WELL COMPLETION OR RECOMPLETION FORM  
ACO-1 WELL HISTORY  
DESCRIPTION OF WELL AND LEASE

Operator: License # AD58  
Name American Wellbore Inc.  
Address P.O. Box 399  
City/State/Zip Garden City, Kans. 67846

Purchaser.....

Operator Contact Person JOHN PALUGA  
Phone 316-275-9231

Wester Kansas Drig Inc. 9039 4087 KCC RT  
Contractor: License #  
Name Wester Kansas Drilling

Wellsite Geologist JOHN PALUGA  
Phone 303-697-1142

Designate Type of Completion  
 New Well     Re-Entry     Workover  
 Oil     SWD     Temp Abd  
 Gas     Inj     Delayed Comp.  
 Dry     Other (Core, Water Supply etc.)

If OWO: old well info as follows:  
Operator .....  
Well Name .....  
Comp. Date ..... Old Total Depth.....

WELL HISTORY

Drilling Method:  
 Mud Rotary     Air Rotary     Cable  
... 1-2-86    ... 1-10-86    ... 1-12-86 ...  
Spud Date    Date Reached TD    Completion Date  
... 4670 ...  
Total Depth    PBTD

Amount of Surface Pipe Set and Cemented at 328 feet.  
Multiple Stage Cementing Collar Used?  Yes  No  
If yes, show depth set.....feet  
If alternate 2 completion, cement circulated from.....feet depth to.....w/.....SX qmt  
Cement Company Name HALL BURTON SERVICES  
Invoice # .....

API NO. 15- 193-20-388-0000

County Thomas

SW NW NE Sec. 30 Twp. 10s Rge. 32 East  West

4290 Ft North from Southeast Corner of Section  
2310 Ft West from Southeast Corner of Section  
(Note: Locate well in section plat below)


Lease Name Close Well # 271

Field Name N/A

Producing Formation.....

Elevation: Ground 3091' KB 3096

Section Plat

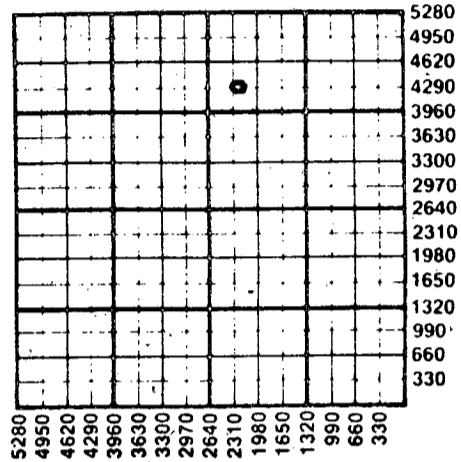

WATER SUPPLY INFORMATION

Disposition of Produced Water:  Disposal  
Docket # .....  Repressuring

Questions on this portion of the ACO-1 call:

Water Resources Board (913) 296-3717

Source of Water:  
Division of Water Resources Permit #.....

Groundwater 4290 Ft North from Southeast Corner (Well) 2310 Ft West from Southeast Corner of Sec 30 Twp 10 Rge 32 East  West

Surface Water.....Ft North from Southeast Corner (Stream, pond etc).....Ft West from Southeast Corner Sec Twp Rge East West

Other (explain) Drilled Water Well on location  
(purchased from city, R.W.D. #)

INSTRUCTIONS: This form shall be completed in duplicate and filed with the Kansas Corporation Commission, 200 Colorado Derby Building, Wichita, Kansas 67202, within 90 days after completion or recompletion of any well. Rule 82-3-130 and 82-3-107 apply. Information on side two of this form will be held confidential for a period of 12 months if requested in writing and submitted with the form. See rule 82-3-107 for confidentiality in excess of 12 months. One copy of all wireline logs and drillers time log shall be attached with this form. Submit CP-4 form with all plugged wells. Submit CP-111 form with all temporarily abandoned wells.

All requirements of the statutes, rules and regulations promulgated to regulate the oil and gas industry have been fully complied with and the statements herein are complete and correct to the best of my knowledge.

Signature Cecil O. Purcell

Title President Date 2-28-86

Subscribed and sworn to before me this 28th day of February 1986

Notary Public Debra J. Purcell

Date Commission Expires 11-4-87

K.C.C. OFFICE USE ONLY  
F  Letter of Confidentiality Attached  
C  Wireline Log Received  
C  Drillers Time Log Received  
Distribution  
KCC  SWD/Rep  NGPA  
KGS  Plug  Other  
(Specify)

Sec. 30 Twp. 10 Rge. 32 W

