

CARD MUST BE TYPED

State of Kansas

CARD MUST BE SIGNED

NOTICE OF INTENTION TO DRILL

(see rules on reverse side)

CORRECTION
3-19-86

Starting Date 12 23 1985
month day year

API Number 15— 193-20,388-0000

OPERATOR: License # 4058
Name .. American Warrior, Inc.
Address .. Hiway 50 West
City/State/Zip .. Garden City, KS 67846
Contact Person .. Cecil Obrate
Phone .. 316-275-7461

SW NE Sec. 30 Twp. 10 S, Rg. 32
4290
2310
East
West
Ft. from South Line of Section
Ft. from East Line of Section

(Note: Locate well on Section Plat on reverse side)

CONTRACTOR: License # 4083
Name .. Western Kansas Drlg., Inc.
City/State .. Hays, Kansas 67601

Nearest lease or unit boundary line .. 330 feet
County Thomas

Well Drilled For: Well Class: Type Equipment:
 Oil SWD Infield Mud Rotary
 Gas Inj Pool Ext. Air Rotary
 OWWO Expl Wildcat Cable

Lease Name Close Well # .. 1
Ground surface elevation feet MSL
Domestic well within 330 feet: —yes no
Municipal well within one mile: —yes no
Surface pipe by Alternate: 2 3
Depth to bottom of fresh water .. 200-250
Depth to bottom of usable water ... 17.50
Surface pipe planned to be set 3.20
Projected Total Depth .. 4600 feet
Formation .. Arbuckle

If OWWO: old well info as follows:

Operator
Well Name
Comp Date Old Total Depth

I certify that well will comply with K.S.A. 55-101, et seq., plus eventually plugging hole to KCC specifications. NESENE
Alternates cementing will be done immediately upon setting production casing. Wors: 3630 FSL
Date 12/15/85 Signature of Operator or Agent Sherril Sholar Title .. as agent 230 FEL

For KCC Use:


Conductor Pipe Required feet; Minimum Surface Pipe Required feet per Alt. 1 2 3
This Authorization Expires 6-13-86 Approved By 12-13-85

Must be filed with the K.C.C. five (5) days prior to commencing well
This card void if drilling not started within six (6) months of date received by K.C.C.

Important procedures to follow:

RECEIVED
STATE CORPORATION COMMISSION
DEC 12 1985
CONSERVATION DIVISION

A Regular Section of Land
1 Mile = 5,280 Ft.

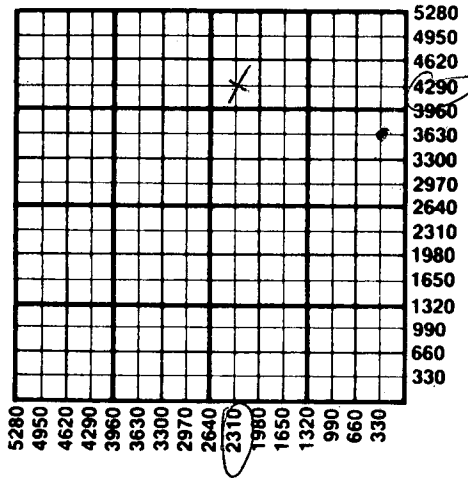

- 1. Notify District office before setting surface casing.
- 2. Set surface casing by circulating cement to the top.
- 3. File completion forms ACO-1 with K.C.C. within 90 days of well completion, following instructions on ACO-1, side 1, and including copies of wireline logs.
- 4. Notify District office 48 hours prior to old well workover or re-entry.
- 5. Prior to filing Intent, prepare a proposed plugging plan in case well is D & A, then obtain approval of plan when calling district office prior to setting surface pipe.
- 6. Submit plugging report (CP-4) to K.C.C. after plugging is completed.
- 7. Obtain an approved injection docket number before disposing of salt water.
- 8. Notify K.C.C. within 10 days when injection commences or terminates.
- 9. If an alternate 2 completion, cement in the production pipe from below any usable water to surface within 120 days of spud date.

State Corporation Commission of Kansas
Conservation Division
200 Colorado Derby Building
Wichita, Kansas 67202
(316) 263-3238