

NOTICE OF INTENTION TO DRILL

(see rules on reverse side)

Starting Date 2-19-86 month day year

OPERATOR: License # 9087
Name R. & C. Drilling Co., Inc.
Address P.O. Box 296
City/State/Zip Hays, KS 67601
Contact Person R. L. Finnesy
Phone 913-625-4548

CONTRACTOR: License # 9087
Name Company Tools
City/State

Well Drilled For: Well Class: Type Equipment:
[X] Oil [ ] SWD [ ] Infield [X] Mud Rotary
[ ] Gas [ ] Inj [X] Pool Ext. [ ] Air Rotary
[ ] OWWO [ ] Expl [ ] Wildcat [ ] Cable

If OWWO: old well info as follows:

Operator
Well Name
Comp Date Old Total Depth

I certify that well will comply with K.S.A. 55-101, et seq., plus eventually plugging hole to KCC specifications.

cementing will be done immediately upon setting production casing.

Date 2-11-86 Signature of Operator or Agent R. L. Finnesy Title R. L. Finnesy, President

For KCC Use:

Conductor Pipe Required feet; Minimum Surface Pipe Required 200 feet per Alt.
This Authorization Expires 2-13-86 Approved By

API Number 15- 193-20,395-0000
CE/1/2 SE SE Sec. 36 Twp. 10 S, Rg. 31
660 Ft. from South Line of Section
330 Ft. from East Line of Section

(Note: Locate well on Section Plat on reverse side)

Nearest lease or unit boundary line 330 feet
County Thomas
Lease Name Maddock Well # 1
Ground surface elevation NA feet MSL
Domestic well within 330 feet: yes X no
Municipal well within one mile: yes X no
Surface pipe by Alternate: 1 2 X
Depth to bottom of fresh water 170
Depth to bottom of usable water 1600
Surface pipe planned to be set 200
Projected Total Depth 4650 feet
Formation Miss.

REH/KOHE


2

Must be filed with the K.C.C. five (5) days prior to commencing well  
This card void if drilling not started within six (6) months of date received by K.C.C.

### Important procedures to follow:

1. Notify District office before setting surface casing.
2. Set surface casing by circulating cement to the top.
3. File completion forms ACO-1 with K.C.C. within 90 days of well completion, following instructions on ACO-1, side 1, and including copies of wireline logs.
4. Notify District office 48 hours prior to old well workover or re-entry.
5. Prior to filing Intent, prepare a proposed plugging plan in case well is D & A, then obtain approval of plan when calling district office prior to setting surface pipe.
6. Submit plugging report (CP-4) to K.C.C. after plugging is completed.
7. Obtain an approved injection docket number before disposing of salt water.
8. Notify K.C.C. within 10 days when injection commences or terminates.

### A Regular Section of Land 1 Mile = 5,280 Ft.

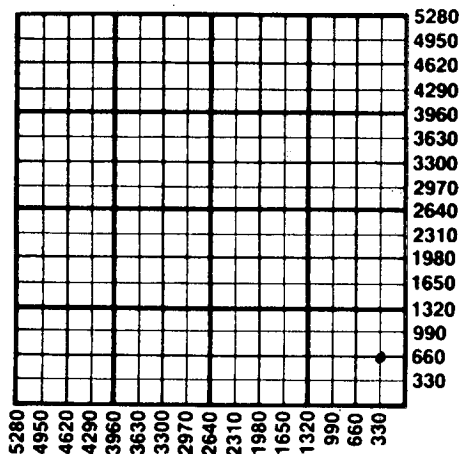

RECEIVED  
STATE CORPORATION COMMISSION

FEB 13 1986  
02-13-86  
CONSERVATION DIVISION  
Wichita, Kansas

9. If an alternate 2 completion, cement in the production pipe from below any usable water to surface within 120 days of spud date.

State Corporation Commission of Kansas  
Conservation Division  
200 Colorado Derby Building  
Wichita, Kansas 67202  
(316) 263-3238