

NOTICE OF INTENTION TO DRILL

Starting Date 2 1 87 month day year

(see rules on reverse side)

API Number 15- C N/2 SE

193-20, 427-0000

OPERATOR: License # 6343 Name Yost Oil Operations, Inc. Address Box 811 City/State/Zip Russell, Kansas 67665 Contact Person Blond Farmer Phone 913-483-6455

Sec 36 Twp 10 S, Rg 31 1980 Ft. from South Line of Section 1320 Ft. from East Line of Section

(Note: Locate well on Section Plat on reverse side)

CONTRACTOR: License # 8241 Name Emphasis Oil Operations City/State Russell, Kansas 67665

Nearest lease or unit boundary line 660 feet County Thomas Lease Name Maddock Well # 1

Well Drilled For: Well Class: Type Equipment: X Oil SWD Infield Mud Rotary Gas Inj Pool Ext Air Rotary OWWO Expl Wildcat Cable

Ground surface elevation NA feet MSL Domestic well within 330 feet: yes X no Municipal well within one mile: yes X no

If OWWO: old well info as follows:

Operator Well Name Comp Date Old Total Depth

Depth to bottom of fresh water 100-200 Depth to bottom of usable water 1620 Surface pipe by Alternate 1 2X Surface pipe planned to be set 250' Conductor pipe required None Projected Total Depth 4600 Formation Mississippi

I certify that well will comply with K.S.A. 55-101, et seq., plus eventually plugging hole to KCC specifications.

Date 1-20-87 Signature of Operator or Agent

Blond Farmer

Title Geologist

For KCC Use:

Conductor Pipe Required feet; Minimum Surface Pipe Required 250 feet per Alt. 4(2) This Authorization Expires 7-22-87 Approved By 1-22-87


Handwritten signature

Must be filed with the K.C.C. five (5) days prior to commencing well
This card void if drilling not started within six (6) months of date received by K.C.C.

Important procedures to follow:

1. Notify District office before setting surface casing.
2. Set surface casing by circulating cement to the top.
3. File completion forms ACO-1 with K.C.C. within 90 days of well completion, following instructions on ACO-1, side 1, and including copies of wireline logs.
4. Notify District office 48 hours prior to old well workover or re-entry.
5. Prior to filing Intent, prepare a proposed plugging plan in case well is D & A, then obtain approval of plan when calling district office prior to setting surface pipe.
6. Submit plugging report (CP-4) to K.C.C. after plugging is completed.
7. Obtain an approved injection docket number before disposing of salt water.
8. Notify K.C.C. within 10 days when injection commences or terminates.

A Regular Section of Land 1 Mile = 5,280 Ft.

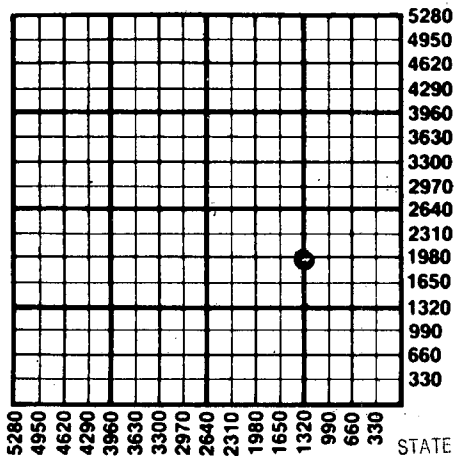

STATE CORPORATION COMMISSION

1-22-87

JAN 22 1987

CONSERVATION DIVISION
Wichita, Kansas

Can alternate 2 completion, cement in the production pipe from below any usable water to surface within 120 days of spud date.

State Corporation Commission of Kansas
Conservation Division
200 Colorado Derby Building
Wichita, Kansas 67202
(316) 263-3238