

15-193-20668-00-00

FOR KCC USE:

FORM C-1 7/91

EFFECTIVE DATE: 7-12-99

FORM MUST BE TYPED

DISTRICT # 4

State of Kansas  
NOTICE OF INTENTION TO DRILL

FORM MUST BE SIGNED

39A7 Yes  No

Must be approved by the K.C.C. five (5) days prior to commencing well

ALL BLANKS MUST BE FILLED

Expected Spud Date 8 1 99 Spot  
month day year ~~4-5-99~~ NW SE Sec 7 Twp 10S 3 Rg 32 East West

OPERATOR: License # 3988  
Name: Slawson Exploration Co., Inc.  
Address: 200 N. Harvey, Ste 1412  
City/State/Zip: Oklahoma City, OK 73102  
Contact Person: Steve Slawson  
Phone: (405) 232-0201

2010 feet from South / West line of Section  
2010 feet from East / West line of Section  
IS SECTION REGULAR  IRREGULAR

CONTRACTOR: License #: 30606  
Name: Murfin Drilling

(NOTE: Locate well on the Section Plat on Reverse Side)  
County: THOMAS  
Lease Name: Park College Well #: #1  
Field Name: WILDCAT

Well Drilled For: Well Class: Type Equipment:  
 Oil ... Enh Rec ... Infield ... Mud Rotary  
... Gas ... Storage ... Pool Ext. ... Air Rotary  
... OUVO ... Disposal  Wildcat ... Cable  
... Seismic: # of Holes ... Other  
... Other

Is this a Prorated/Spaced Field? ... yes  no   
Target Formation(s): LKC, Cherokee  
Nearest lease or unit boundary: 630'   
Ground Surface Elevation: est 3081 feet MSL

If OUVO: old well information as follows:  
Operator:  
Well Name:  
Comp. Date: Old Total Depth

Water well within one-quarter mile:  yes  no  
Public water supply well within one mile:  yes  no  
Depth to bottom of fresh water: 220'  
Depth to bottom of usable water: 1940'

Directional, Deviated or Horizontal wellbore? ... yes  no  
If yes, true vertical depth:  
Bottom Hole Location:

Surface Pipe by Alternate: 1  2  
Length of Surface Pipe Planned to be set: 300'  
Length of Conductor pipe required: N/A  
Projected Total Depth: 4700'

Formation at Total Depth: Mississippi  
Water Source for Drilling Operations:  
 well  farm pond  other  
DWR Permit #: Apply to DWR FOR PERMIT

Will Cores Be Taken? ... yes  no  
If yes, proposed zone:

AFFIDAVIT

The undersigned hereby affirms that the drilling, completion and eventual plugging of this well will comply with K.S.A. 55-101, et. seq.

It is agreed that the following minimum requirements will be met:

- 1. Notify the appropriate district office prior to spudding of well;
- 2. A copy of the approved notice of intent to drill shall be posted on each drilling rig;
- 3. The minimum amount of surface pipe as specified below shall be set by circulating cement to the top; in all cases surface pipe shall be set through all unconsolidated materials plus a minimum of 20 feet into the underlying formation;
- 4. If the well is dry hole, an agreement between the operator and the district office on plug length and placement is necessary prior to plugging;
- 5. The appropriate district office will be notified before well is either plugged or production casing is cemented in;
- 6. IF AN ALTERNATE II COMPLETION, PRODUCTION PIPE SHALL BE CEMENTED FROM BELOW ANY USABLE WATER TO SURFACE WITHIN 120 DAYS OF SPUD DATE. IN ALL CASES, NOTIFY DISTRICT OFFICE PRIOR TO ANY CEMENTING.

I hereby certify that the statements made herein are true and to the best of my knowledge and belief.

Date: 7-2-99 Signature of Operator or Agent: Title: Div. Oper: Mgr

FOR KCC USE:  
API # 15-193-20668-0000  
Conductor pipe required NONE feet  
Minimum surface pipe required 240 feet per Alt. X(2)  
Approved by: DPW 7-7-99  
This authorization expires: 1-7-2000  
(This authorization void if drilling not started within 6 months of effective date.)  
Spud date: Agent:

RECEIVED  
ANSAS CORP CO:11  
1999 JUL -6 P 1:46  
7-6-99

REMEMBER TO:

- File Drill Pit Application (form CDP-1) with Intent to Drill;
- File Completion Form ACO-1 within 120 days of spud date;
- File acreage attribution plat according to field proration orders;
- Notify appropriate district office 48 hours prior to workover or re-entry;
- Submit plugging report (CP-4) after plugging is completed;
- Obtain written approval before disposing or injecting salt water.

Mail to: Conservation Division, 200 Colorado Derby Building, 202 W. First St., Wichita, Kansas 67202-1286.

7  
10  
324

IN ALL CASES PLOT THE INTENDED WELL ON THE PLAT BELOW

PLAT OF ACREAGE ATTRIBUTABLE TO A WELL IN A PRORATED OR SPACED FIELD

If the intended well is in a prorated or spaced field, please fully complete this side of the form. If the intended well is in a prorated or spaced field complete the plat below showing that the well will be properly located in relationship to other wells producing from the common source of supply. Please show all the wells within 1 mile of the boundaries of the proposed acreage attribution unit for gas wells and within 1/2 mile of the boundaries of the proposed acreage attribution unit for oil wells.



API NO. 15- \_\_\_\_\_  
 OPERATOR \_\_\_\_\_ LOCATION OF WELL: COUNTY \_\_\_\_\_  
 LEASE \_\_\_\_\_ feet from south/north line of section  
 WELL NUMBER \_\_\_\_\_ feet from east/west line of section  
 FIELD \_\_\_\_\_ SECTION \_\_\_\_\_ TWP \_\_\_\_\_ RG \_\_\_\_\_

NUMBER OF ACRES ATTRIBUTABLE TO WELL \_\_\_\_\_ IS SECTION \_\_\_\_\_ REGULAR or \_\_\_\_\_ IRREGULAR  
 QTR/QTR/QTR OF ACREAGE \_\_\_\_\_ IF SECTION IS IRREGULAR, LOCATE WELL FROM NEAREST  
CORNER BOUNDARY.

Section corner used: \_\_\_\_\_ NE \_\_\_\_\_ NW \_\_\_\_\_ SE \_\_\_\_\_ SW

PLAT

(Show location of the well and shade attributable acreage for prorated or spaced wells.)  
 (Show footage to the nearest lease or unit boundary line.)

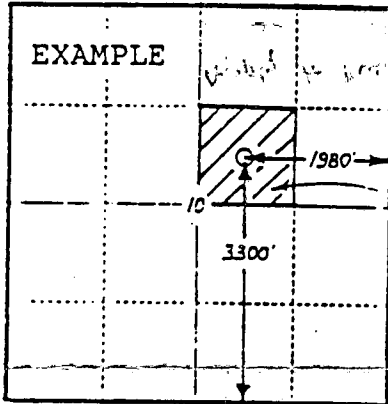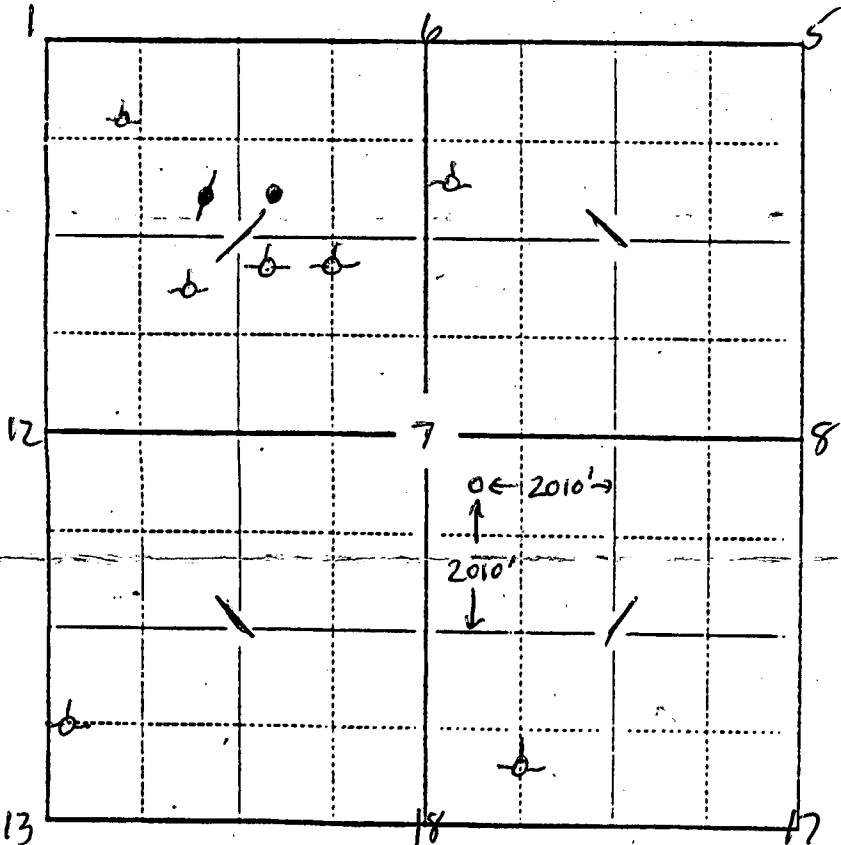

SEWARD CO.

In plotting the proposed location of the well, you must show:

- 1) The manner in which you are using the depicted plat by identifying section lines, i.e. 1 section, 1 section with 8 surrounding sections, 4 sections, etc.;
- 2) the distance of the proposed drilling location from the section's south/north and east/west lines; and
- 3) the distance to the nearest lease or unit boundary line.