

CARD MUST BE TYPED

State of Kansas

CARD MUST BE SIGNED

16 NOTICE OF INTENTION TO DRILL

(see rules on reverse side)

Expected Spud Date. SEPTEMBER 11, 1987

API Number 15— 193-20,448-00-00

OPERATOR: License # #7630

NW SW SE 6 10 32 —X East
Sec. 800 Twp. S, Rg. — West

Name WESTERN KANSAS EXPLORATION

Address 2700 OAK

City/State/Zip HAYS, KANSAS 67601

Contact Person. STAN YOUNGER

Phone. (913) 628-2296

. 2290 Ft. from South Line of Section
. Ft. from East Line of Section

(Note: Locate well on Section Plat on reverse side)

Nearest lease or unit boundary line 350 feet

County. THOMAS

Lease Name. MURPHY Well # 1

CONTRACTOR: License # 4083

Name WESTERN KANSAS DRILLING, INC.

City/State P.O. BOX 126, HAYS, KANSAS 67601

Ground surface elevation feet MSL

Domestic well within 330 feet: —yes X no

Municipal well within one mile: —yes X no

Depth to bottom of fresh water. 225

Depth to bottom of usable water. 1850

Surface pipe by Alternate: 1 — X

Surface pipe planned to be set 275

Conductor pipe required

Projected Total Depth 4600 feet

Formation. MISSISSIPPIAN

Well Drilled For: Well Class: Type Equipment:

X Oil Storage Infield X Mud Rotary

Gas Inj Pool Ext. Air Rotary

OWWO Expl X Wildcat Cable

If OWWO: old well info as follows:

Operator

Well Name

Comp Date Old Total Depth.

I certify that well will comply with K.S.A. 55-101, et seq., plus eventually plugging hole to KCC specifications.

Date 09/11/87 Signature of Operator or Agent G. Deeg Engelman Title. AS AGENT

For KCC Use:

Conductor Pipe Required feet; Minimum Surface Pipe Required 275 feet per Alt. X (2)

This Authorization Expires 3-11-88 Approved By 9-11-87


Effective 9-16-87

Must be filed with the K.C.C. five (5) days prior to commencing well
This card void if drilling not started within six (6) months of date received by K.C.C.

Important procedures to follow:

1. Notify District office before setting surface casing.
2. Set surface casing by circulating cement to the top.
3. File completion forms ACO-1 with K.C.C. within 120 days of well spud date, following instructions on ACO-1, side 1, and including copies of wireline logs.
4. Notify District office 48 hours prior to old well workover or re-entry.
5. Prior to filing Intent, prepare a proposed plugging plan in case well is D & A, then obtain approval of plan when calling district office prior to setting surface pipe.
6. Submit plugging report (CP-4) to K.C.C. after plugging is completed.
7. Obtain an approved injection docket number before disposing of salt water.
8. Notify K.C.C. within 10 days when injection commences or terminates.
9. If an alternate 2 completion cement in the production pipe from below any usable water to surface within 120 days of spud date.

**A Regular Section of Land
1 Mile = 5,280 Ft.**

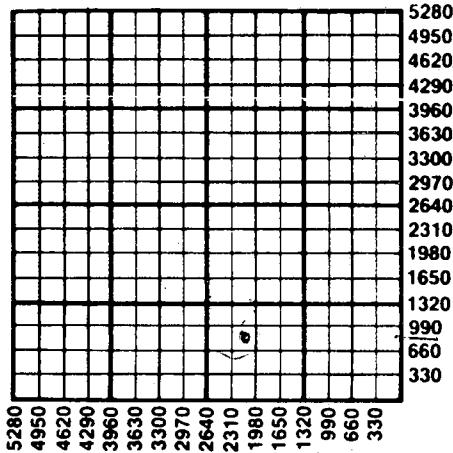

Wichita, Kansas
09-11-87

STATE CORPORATION COMMISSION
Conservation Division
200 Colorado Derby Building
Wichita, Kansas 67202-1212
(316) 263-3238