

CARD MUST BE TYPED

State of Kansas
NOTICE OF INTENTION TO DRILL

CARD MUST BE SIGNED

(see rules on reverse side)

Starting Date: December 10, 1985
month day year

API Number 15- 193-20,382-0000
SW SE NW Sec 36 Twp 10 S, Rge 32 East West
(location)

OPERATOR: License # 5063
Name Energy Exploration, Inc.
Address 1002 South Broadway
City/State/Zip Wichita, Kansas 67211
Contact Person Brad Lehl
Phone (316) 267-7336

2970 Ft North from Southeast Corner of Section
3630 Ft West from Southeast Corner of Section
(Note: Locate well on Section Plat on reverse side)

CONTRACTOR: License # 5422
Name Abercrombie Drilling, Inc.
City/State 801 Union Center, Wichita, Ks

Nearest lease or unit boundary line 330 feet.
County Thomas
Lease Name George Well# 1

Well Drilled For: Well Class: Type Equipment:
 Oil Swd Infield Mud Rotary
 Gas Inj Pool Ext. Air Rotary
 OWWO Expl Wildcat Cable

Domestic well within 330 feet: yes no
Municipal well within one mile: yes no

If OWWO: old well info as follows:
Operator
Well Name
Comp Date Old Total Depth
Projected Total Depth 4700 feet
Projected Formation at TD Mississippian
Expected Producing Formations Lansing, Marmaton, Cherokee

Depth to Bottom of fresh water 250 feet
Lowest usable water formation Dakota
Depth to Bottom of usable water 1700 feet
Surface pipe by Alternate: 1 2
Surface pipe to be set 300 feet
Conductor pipe if any required none feet
Ground surface elevation not available feet MSL
This Authorization Expires 5-27-86
Approved By 11-27-85

I certify that we will comply with K.S.A. 55-101, et seq., plus eventually plugging hole to K.C.C. specifications.

Date 11/26/85 Signature of Operator or Agent *Brad Lehl* Title President


RECH/10/11/85

*Production string will be cemented immediately in order to protect the Dakota.

Must be filed with the K.C.C. five (5) days prior to commencing well
This card void if drilling not started within six (6) months of date received by K.C.C.

Important procedures to follow:

**A Regular Section of Land
1 Mile = 5,280 Ft.**

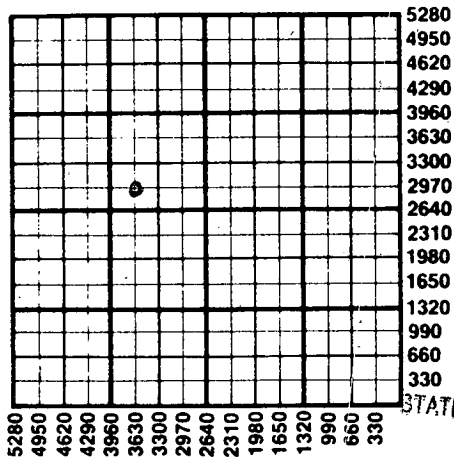

1. Notify District office before setting surface casing.
2. Set surface casing by circulating cement to the top.
3. File completion forms ACO-1 with K.C.C. within 90 days of well completion, following instructions on ACO-1, side 1, and including copies of wireline logs.
4. Notify District office 48 hours prior to old well workover or re-entry.
5. Prior to plugging, prepare a plugging plan, then obtain agreement from the appropriate district office for an approved plugging plan.
6. Submit plugging report (CP-4) to K.C.C. after plugging is completed.
7. Obtain an approved injection docket number before disposing of salt water.
8. Notify K.C.C. within 10 days when injection commences or terminates.
9. If an alternate 2 completion, cement in the production pipe from below (any usable water to surface within 120 days of spud date.

RECEIVED
STATE CORPORATION COMMISSION

State Corporation Commission of Kansas

Conservation Division

200 Colorado Derby Building

Wichita, Kansas 67202

(316) 263-3238

NOV 27 1985
11-27-85
CONSERVATION DIVISION
Wichita, Kansas