

CARD MUST BE TYPED

State of Kansas

CARD MUST BE SIGNED ✓

NOTICE OF INTENTION TO DRILL

(see rules on reverse side)

Expected Spud Date: 7 / 20 / 1987
month day year

API Number 15— 193-20,443-0000

OPERATOR: License # 4629
Name Brito Oil Company, Inc.
Address 200 E. First, Suite 413
City/State/Zip Wichita, Kansas 67202
Contact Person Mr. Raul Brito
Phone 316-263-8787

NW SE SW 36 Sec. Twp. 10 S, Rg. 32 XX East West
990 Ft. from South Line of Section
3630 Ft. from East Line of Section

(Note: Locate well on Section Plat on reverse side)

CONTRACTOR: License # 5422
Name Abercrombie Drilling, Inc.
City/State Wichita, Kansas 67202

Nearest lease or unit boundary line 990 feet
County Thomas
Lease Name Double S Well # 1
Ground surface elevation 3035 feet MSL
Domestic well within 330 feet: — yes X no
Municipal well within one mile: — yes X no
Depth to bottom of fresh water 220'
Depth to bottom of usable water 1700'
Surface pipe by Alternate: 1 XX
Surface pipe planned to be set 300'
Conductor pipe required None
Projected Total Depth 4700 feet
Formation Mississippi

Well Drilled For: Well Class: Type Equipment:
X Oil — Storage — Infield X Mud Rotary
— Gas — Inj — Pool Ext. — Air Rotary
— OWWO — Expl X Wildcat — Cable

If OWWO: old well info as follows:

Operator
Well Name
Comp Date Old Total Depth

I certify that well will comply with K.S.A. 55-101, et seq., plus eventually plugging hole to KCC specifications.
Date 7-16-87 Signature of Operator or Agent [Signature] Title President

For KCC Use:


Conductor Pipe Required feet; Minimum Surface Pipe Required 250 feet per Alt. X (2)
This Authorization Expires 1-20-88 Approved By [Signature] 7-20-87

Must be filed with the K.C.C. five (5) days prior to commencing well
This card void if drilling not started within six (6) months of date received by K.C.C.

Important procedures to follow:

1. Notify District office before setting surface casing.
2. Set surface casing by circulating cement to the top.
3. File completion forms ACO-1 with K.C.C. within 120 days of well spud date, following instructions on ACO-1, side 1, and including copies of wireline logs.
4. Notify District office 48 hours prior to old well workover or re-entry.
5. Prior to filing Intent, prepare a proposed plugging plan in-case well is D & A, then obtain approval of plan when calling district office prior to setting surface pipe.
6. Submit plugging report (CP-4) to K.C.C. after plugging is completed.
7. Obtain an approved injection docket number before disposing of salt water.
8. Notify K.C.C. within 10 days when injection commences or terminates.
9. If an alternate 2 completion, cement in the production pipe from below any usable water to surface within 120 days of spud date.

**A Regular Section of Land
1 Mile = 5,280 Ft.**

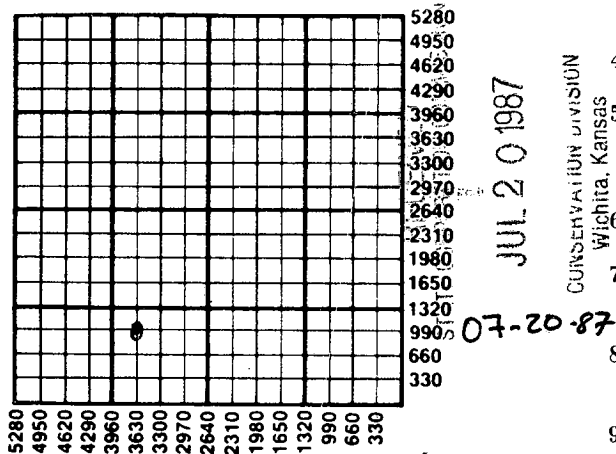

State Corporation Commission of Kansas
Conservation Division
200 Colorado Derby Building
Wichita, Kansas 67202-1212
(316) 263-3238