

CARD MUST BE TYPED

State of Kansas
NOTICE OF INTENTION TO DRILL

CARD MUST BE SIGNED

(see rules on reverse side)

Starting Date: ... November 5, 1984 ...
month day year

API Number 15- 193-20,329-0000

OPERATOR: License # 5063

N/2 NW NW Sec 16 Twp 10 S, Rge 33 East
(location) West

Name Energy Exploration, Inc.

Address 1002 S. Broadway

City/State/Zip Wichita, KS 67211

Contact Person Brad D. Lehl

Phone (316) 267-7336

4950' Ft North from Southeast Corner of Section

4620' Ft West from Southeast Corner of Section

(Note: Locate well on Section Plat on reverse side)

CONTRACTOR: License # 5422

Nearest lease or unit boundary line 330 feet.

County Thomas

Name Abercrombie Drilling, Inc.

Lease Name Hansen Well# #1

City/State 801 Union Center, Wichita, KS 67207

Domestic well within 330 feet: yes no

Municipal well within one mile: yes no

Well Drilled For: Well Class: Type Equipment:

- Oil Swd Infield Mud Rotary
- Gas Inj Pool Ext. Air Rotary
- OWWO Expl Wildcat Cable

Depth to Bottom of fresh water 250 feet

Lowest usable water formation Dakota

Depth to Bottom of usable water 1800 feet

Surface pipe by Alternate: 1 2

Surface pipe to be set 330' feet

Conductor pipe if any required none feet

Ground surface elevation 3179 feet MSL

This Authorization Expires 4-25-85

Approved By 10-25-84 [Signature]

If OWWO: old well info as follows:

Operator

Well Name

Comp Date Old Total Depth

Projected Total Depth 4800 feet

Projected Formation at TD Mississippian

Expected Producing Formations Lansing-Kansas City

I certify that we will comply with K.S.A. 55-101, et seq., plus eventually plugging hole to K.C.C. specifications.

Date 10-22-84 Signature of Operator or Agent

[Signature] Title President


mhe/udhe 10/25/84 Form C-1 4/84

RECEIVED
STATE CORPORATION COMMISSION

Must be filed with the K.C.C. five (5) days prior to commencing well
This card void if drilling not started within six (6) months of date received by K.C.C.

OCT 25 1984

A Regular Section of Land
1 Mile = 5,280 Ft.

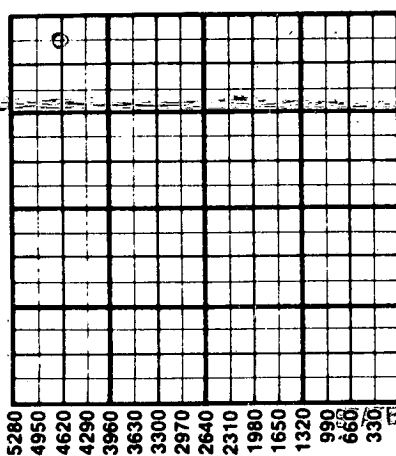

Important procedures to follow:

1. Notify District office before setting surface casing.
2. Set surface casing by circulating cement to the top.
3. File completion forms ACO-1 with K.C.C. within 90 days of well completion, following instructions on ACO-1, side 1, and including copies of wireline logs.
4. Notify District office 48 hours prior to old well workover or re-entry.
5. Prior to plugging, prepare a plugging plan, then obtain agreement from the appropriate district office for an approved plugging plan.
6. Submit plugging report (CP-4) to K.C.C. after plugging is completed.
7. Obtain an approved injection docket number before disposing of salt water.
8. Notify K.C.C. within 10 days when injection commences or terminates.
9. If an alternate 2 completion, cement in the production pipe from below any usable water to surface within 120 days of spud date.

RECEIVED
CORPORATION COMMISSION

10-23-84
OCT 23 1984

CONSERVATION DIVISION
Wichita, Kansas

State Corporation Commission of Kansas
Conservation Division
200 Colorado Derby Building
Wichita, Kansas 67202
(316) 263-3238