

STATE CORPORATION COMMISSION OF KANSAS
OIL & GAS CONSERVATION DIVISION

WELL COMPLETION OR RECOMPLETION FORM
ACO-1 WELL HISTORY

DESCRIPTION OF WELL AND LEASE

Operator: license # 5146
name Rains & Williamson Oil Co., Inc.
address 435 Page Court, 220 W. Douglas
Wichita, Kansas 67202
City/State/Zip

Operator Contact Person Juanita Green
Phone 265-9686

Contractor: license #
name Rains & Williamson Oil Co., Inc.

Wellsite Geologist
Phone

PURCHASER

Designate Type of Completion
 New Well Re-Entry Workover

Oil SWD Temp Abd
 Gas Inj Delayed Comp.
 Dry Other (Core, Water Supply etc.)

If OWWO: old well info as follows:
Operator
Well Name
Comp. Date Old Total Depth

WELL HISTORY

Drilling Method: Mud Rotary Air Rotary Cable

3-3-86 3-8-86 3-8-86
Spud Date Date Reached TD Completion Date

3217'
Total Depth PBDT

Amount of Surface Pipe Set and Cemented at 290' feet

Multiple Stage Cementing Collar Used? Yes No

If Yes, Show Depth Set feet

If alternate 2 completion, cement circulated
from feet depth to w/ SX cmt

API NO. 15- 167-22,738-00-00

County Russell

SW SE NW Sec. 29 Twp. 11S Rge. 14 X
(location)

2970 Ft North from Southeast Corner of Sec
3630 Ft West from Southeast Corner of Sec
(Note: locate well in section plat below)


Lease Name Strecker "A" Well# 2

Field Name

Producing Formation

Elevation: Ground 1826 KB 1831

Section Plat

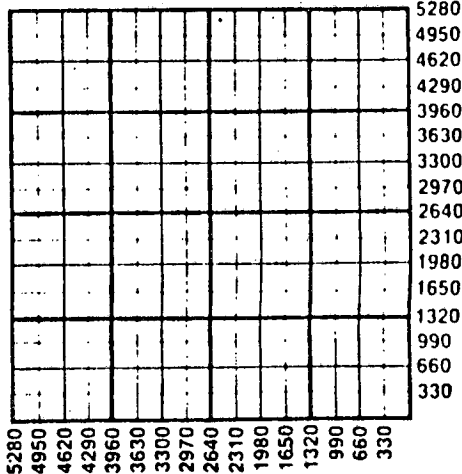

WATER SUPPLY INFORMATION

Source of Water:

Division of Water Resources Permit #

Groundwater (Well) Ft North From Southeast Corner
Ft. West From Southeast Corn
Sec Twp Rge East West

Surface Water (Stream, Pond etc.) Ft North From Southeast Corner
Ft West From Southeast Co
Sec Twp Rge East West

Other (explain) (purchased from city, R.W.D.#)

Disposition of Produced Water: Disposal Repressuring

Docket #

INSTRUCTIONS: This form shall be completed in duplicate and filed with the Kansas Corporation Commission, 200 Colorado Derby Building, Wichita, Kansas 67202, within 90 days after completion or recompletion of any well. Rules 82-3-130 and 82-3-107 apply.

Information on side two of this form will be held confidential for a period of 12 months if requested in writing and submitted with the form. See rule 82-3-107 for confidentiality in excess of 12 months.

One copy of all wireline logs and drillers time log shall be attached with this form. Submit CP-4 form with all plugged wells. Submit CP-111 form with all temporarily abandoned wells.

All requirements of the statutes, rules, and regulations promulgated to regulate the oil and gas industry have been fully complied with and the statements herein are complete and correct to the best of my knowledge.

Signature Wilson Rains
Title President Date 3-26-86

Subscribed and sworn to before me on 26 day of March 19 86
Notary Public State of Kansas My Appl. Exp. Oct. 4, 1987
Date Commission Expires 10-4-87

K.C.C. OFFICE USE ONLY
 Letter of Confidentiality Attached
 Wireline Log Received
 Drillers Timelog Received
Distribution
 KCC SWD/Rep NGPA
 KGS Plug Other (Specify)