

ORIGINAL

SIDE ONE

STATE CORPORATION COMMISSION OF KANSAS
OIL & GAS CONSERVATION DIVISION
WELL COMPLETION FORM
ACO-1 WELL HISTORY
DESCRIPTION OF WELL AND LEASE

API NO. 15- 193-20, 563 -00 -00

County Thomas

W/2 SW NE Sec. 27 Twp. 10S Rge. 32W East West

3360 Ft. North from Southeast Corner of Section

2310 Ft. West from Southeast Corner of Section
(NOTE: Locate well in section plat below.)


Lease Name Krug Well # 1

Field Name Unnamed

Producing Formation _____

Elevation: Ground 3044 KB 3049

Total Depth 4680 PBD _____

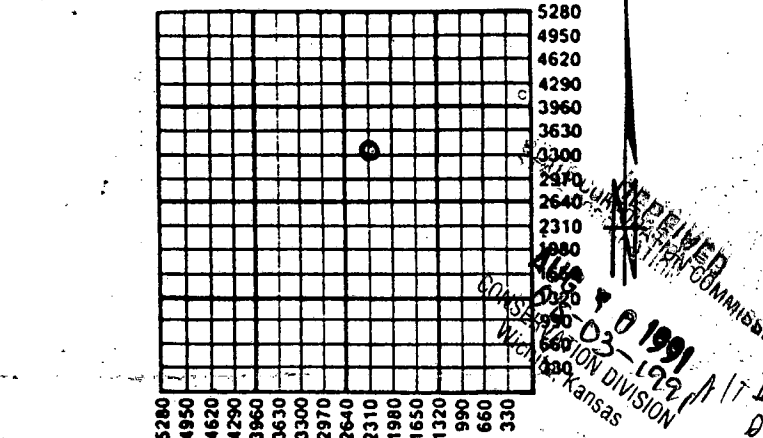

Amount of Surface Pipe Set and Cemented at 276 Feet

Multiple Stage Cementing Collar Used? Yes No

If yes, show depth set _____ Feet

If Alternate II completion, cement circulated from _____

feet depth to _____ w/ _____ sx cmt.

Operator: License # 30269

Name: Argent Energy, Inc.

Address 110 S. Main

Suite 510

City/State/Zip Wichita, KS 67202

Purchaser: _____

Operator Contact Person: James C. Remsberg

Phone (316) 262-5111

Contractor: Name: Murfin Drilling Company, Inc.

License: 30606

Wellsite Geologist: _____

Designate Type of Completion

New Well Re-Entry Workover

Oil SWD Temp. Abd.

Gas Inj Delayed Comp.

Dry Other (Core, Water Supply, etc.)

If OMO: old well info as follows:

Operator: _____

Well Name: _____

Comp. Date _____ Old Total Depth _____

Drilling Method:

Mud Rotary Air Rotary Cable

07-08-91 07-16-91 07-17-91

Spud Date Date Reached TD Completion Date

INSTRUCTIONS: This form shall be completed in triplicate and filed with the Kansas Corporation Commission, 200 Colorado Derby Building, Wichita, Kansas 67202, within 120 days of the spud date of any well. Rule 82-3-130, 82-3-107 and 82-3-106 apply. Information on side two of this form will be held confidential for a period of 12 months if requested in writing and submitted with the form. See rule 82-3-107 for confidentiality in excess of 12 months. One copy of all wireline logs and drillers time log shall be attached with this form. ALL CEMENTING TICKETS MUST BE ATTACHED. Submit CP-4 form with all plugged wells. Submit CP-111 form with all temporarily abandoned wells. Any recompletion, workover or conversion of a well requires filing of ACO-2 within 120 days from commencement date of such work.

All requirements of the statutes, rules and regulations promulgated to regulate the oil and gas industry have been fully complied with and the statements herein are complete and correct to the best of my knowledge.

Signature James C. Remsberg
James C. Remsberg
Title President Date _____

Subscribed and sworn to before me this 29th day of August,
19 91.

Notary Public Julie O. Koker

Date Commission Expires December 4, 1993

K.C.C. OFFICE USE ONLY		
F	<input type="checkbox"/>	Letter of Confidentiality Attached
C	<input checked="" type="checkbox"/>	Wireline Log Received
C	<input type="checkbox"/>	Drillers Timelog Received
Distribution		
<input checked="" type="checkbox"/>	KCC	<input type="checkbox"/> SWD/Rep
<input type="checkbox"/>	KGS	<input type="checkbox"/> Plug
		<input type="checkbox"/> NGPA
		<input type="checkbox"/> Other
		(Specify)

JULIE O. KOKER
- NOTARY PUBLIC
STATE OF KANSAS
My Appt. Exp. 12-4-93

Phone 913-483-2627, Russell, Kansas

Phone Plainville 913-434-2812

Phone 316-793-5861, Great Bend, Kansas

Phone Ness City 913-798-3843

15-193-20563-00-00

No 2004

ALLIED CEMENTING CO., INC.

Home Office P. O. Box 31

Russell, Kansas 67665

ORIGINAL

New

Date	7-16-91	Sec.	27	Twp.	10	Range	32	Called Out	4:00 PM	On Location	7:15 PM	Job Start	8:45 PM	Finish	1:00 AM
Lease	Krug	Well No.	#1	Location	Oakley in 3rd tier			County	Thomas	State	Kansas				
Contractor	Martin Drig	Owner	SAME												
Type Job	Plug														
Hole Size	7 7/8"	T.D.	4680'												
Csg.	8 3/8"	Depth	276'												
Tbg. Size		Depth													
Drill Pipe		Depth													
Tool		Depth													
Cement Left in Csg.		Shoe Joint													
Press Max.		Minimum													
Meas Line		Displace													
Perf.															

To Allied Cementing Co., Inc.
You are hereby requested to rent cementing equipment and furnish cementer and helper to assist owner or contractor to do work as listed.

Charge To **Argent Energy Inc.**
 Street **40 S Main # 510**
 City **Wichita** State **Kansas**

The above was done to satisfaction and supervision of owner agent or contractor.

Purchase Order No.

X

CEMENT

Amount Ordered **200 SKS 60/40 Poz 6 7/8" 1/4 Flo-S**

Consisting of

Common	120 @ 6.10	732.00
Poz. Mix	80 @ 2.40	192.00
Gel.	7 @ 6.75	47.25
Chloride		
Quickset		
Flo Semi.	2 @ 25.00	50.00

Sales Tax

Handling @ 1.00 = 200.00

Mileage 4¢/SK / M.I.E = 45.00

Sub Total

RECEIVED
 STATE CORPORATION CO
 Total **1286.25**

Floating Equipment

AUG 30 1991

CONSERVATION DIVISION
Wichita, Kansas

Thank you

EQUIPMENT

#177	No.	Cementer	<i>M. Kaufman</i>
Pumptrk		Helper	<i>Glenn G.</i>
	No.	Cementer	
Pumptrk		Helper	
#213		Driver	<i>Paul D.</i>
Bulktrk		Driver	

DEPTH of Job

Reference:	#	PUMP Trk	380.00
		1-8 3/8" Plug	20.00
		2.00 Per M.I.E	10.00
		Sub Total	
		Tax	
		Total	410.00

Remarks:

- 25 SKS @ 2600'
- 100 SKS @ 1750'
- 40 SKS @ 300'
- 10 SKS @ 40'
- 15 SKS in Rat Hole
- 10 SKS in Mouse Hole

ALLIED CEMENTING CO., INC.

Home Office P. O. Box 31

Russell, Kansas 67665

ORIGINAL

New

Date	7-8-91	Sec.	27	fwp.	10	Range	32W	Called Out		On Location		Job Start		Finish	7:45 PM
Lease	Krug	Well No.	1	Location	Oakley 1W2N2W4S			County	Thomas	State	Ks				
Contractor	Martin Drlg														
Type Job	Surface														
Hole Size	12 1/4	T.D.	276												
Csg.	8 3/8	Depth	276												
Tbg. Size		Depth													
Drill Pipe		Depth													
Tool		Depth													
Cement Left in Csg.	10 1/2	Shoe Joint													
Press Max.		Minimum													
Meas Line		Displace													
Perf.															

Owner
 To Allied Cementing Co., Inc.
 You are hereby requested to rent cementing equipment and furnish cementer and helper to assist owner or contractor to do work as listed.

Charge To *Argent Energy Inc*
 Street *110 S Main #510*
 City *Wichita* State *Kan* *67202*

The above was done to satisfaction and supervision of owner agent or contractor.

Purchase Order No. *[Signature]*

X *[Signature]*
CEMENT
1 gal premix
 Amount Ordered *170.00 3% CC 2% gel*

EQUIPMENT

Pumptrk	No. <i>153</i>	Cementer	<i>Dave</i>
		Helper	<i>Jerald</i>
Pumptrk	No.	Cementer	
		Helper	
Bulktrk	<i>213</i>	Driver	<i>Lawrence</i>
Bulktrk		Driver	

Consisting of

Common	102	6.10	622.2
Poz. Mix	68	2.40	163.2
Gel.	3	6.75	N/C
Chloride	5	21.00	105.00
Quickset			
		Sales Tax	
Handling	1.00		170.00
Mileage	<i>Min</i>	.04	45.00
		Sub Total	1105.40
		Total	

DEPTH of Job

Reference:	<i>Pump trk chg</i>	380.00
	<i>2¢ per mile 3m</i>	6.00
	<i>8' wooden plug</i>	42.00
	Sub Total	428.00
	Tax	
	Total	

Remarks:

Cement Cir

Floating Equipment

STATE COMMISSION
RECEIVED
AUG 30 1991
 CONSERVATION DIVISION
 Wichita, Kansas