

STATE OF KANSAS
STATE CORPORATION COMMISSION

WELL PLUGGING RECORD

Give All Information Completely
Make Required Affidavit
Mail or Deliver Report to:
Conservation Division
State Corporation Commission
800 Bitting Building
Wichita, Kansas

Russell County. Sec. 26 Twp. 11S Rge. 15 (W)

Location as "NE/CNW $\frac{1}{4}$ SW $\frac{1}{4}$ " or footage from lines SW NW SE

Lease Owner B. H. P

Lease Name Eulert Well No. 1

Office Address Box 62, Great Bend, Kansas

Character of Well (completed as Oil, Gas or Dry Hole) Dry Hole

Date well completed October 2 19 50

Application for plugging filed October 4 19 50

Application for plugging approved October 10 19 50


Plugging commenced October 19 19 50

Plugging completed October 24 19 50

Reason for abandonment of well or producing formation

If a producing well is abandoned, date of last production 19

Was permission obtained from the Conservation Division or its agents before plugging was commenced? Yes

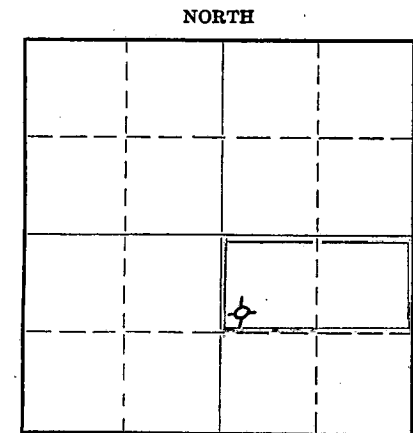

Locate well correctly on above Section Plat

Name of Conservation Agent who supervised plugging of this well Eldon Petty

Producing formation Depth to top Bottom Total Depth of Well 3385 Feet

Show depth and thickness of all water, oil and gas formations. P.B. 2975

OIL, GAS OR WATER RECORDS

CASING RECORD

Formation	Content	From	To	Size	Put In	Pulled Out
				8-5/8"	360'	X
				5-1/2"	3381'	2717'

Describe in detail the manner in which the well was plugged, indicating where the mud fluid was placed and the method or methods used in introducing it into the hole. If cement or other plugs were used, state the character of same and depth placed, from 2765 feet to feet for each plug set.

Bridged with sand from 2765 to 2750; cemented with 5 sacks from 2750 to 2720 feet; mudded from 2720 to 260 feet; bridged with rock from 260 to 245 feet; cemented with 15 sacks from 245 to 200 feet; mudded from 200 to 30 feet; and cemented with 10 sacks from 30 feet to cellar.

RECEIVED
STATE CORPORATION COMMISSION
10-31-1950
OCT 31 1950
CONSERVATION DIVISION
Wichita, Kansas

(If additional description is necessary, use BACK of this sheet)

Correspondence regarding this well should be addressed to B. H. P

Address Box 62, Great Bend, Kansas

STATE OF KANSAS, COUNTY OF BARTON, ss.
Leon F. Huff, Partner of B - H - P


(employee of owner) or (owner or operator) of the above-described well, being first duly sworn on oath, says: That I have knowledge of the facts, statements, and matters herein contained and the log of the above-described well as filed and that the same are true and correct. So help me God.

(Signature) Leon F. Huff

P. O. Box 62, Great Bend, Kansas (Address)

SUBSCRIBED AND SWORN to before me this 30th day of October, 19 50

My commission expires March 6, 1954. Mildred Habbe Notary Public.

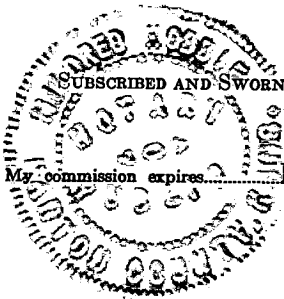

PLUGGING
FILE SEC 26 T 11 R 15
BOOK PAGE 39 LINE 1

