


WELL PLUGGING RECORD

Give All Information Completely
Make Required Affidavit
Mail or Deliver Report to:
Conservation Division
State Corporation Commission
800 Bitting Building
Wichita, Kansas

Russell County. Sec 26 Twp. 11S Rge. 15 (E) 15 (W)
Location as "NE/CNW/SW" or footage from lines NE NE SW
Lease Owner Jones, Shelburne & Farmer, Inc.
Lease Name Eulert Well No. 1
Office Address Russell, Kansas
Character of Well (completed as Oil, Gas or Dry Hole) dry
Date well completed 12-28 19 54
Application for plugging filed 12-28 19 54
Application for plugging approved 12-28 19 54
Plugging commenced 12-28 19 54
Plugging completed 12-28 19 54
Reason for abandonment of well or producing formation dry

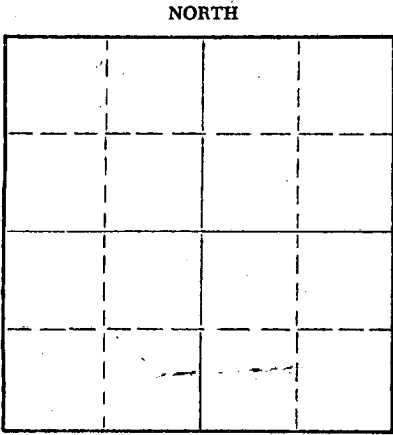

Locate well correctly on above Section Plat

If a producing well is abandoned, date of last production never produced 19
Was permission obtained from the Conservation Division or its agents before plugging was commenced? yes

Name of Conservation Agent who supervised plugging of this well Eldon Petty
Producing formation _____ Depth to top _____ Bottom _____ Total Depth of Well 3390 Feet
Show depth and thickness of all water, oil and gas formations.

OIL, GAS OR WATER RECORDS

CASING RECORD

FORMATION	CONTENT	FROM	TO	SIZE	PUT IN	PULLED OUT
				8 5/8	160	none

Describe in detail the manner in which the well was plugged, indicating where the mud fluid was placed and the method or methods used in introducing it into the hole. If cement or other plugs were used, state the character of same and depth placed, from _____ feet to _____ feet for each plug set.

1. Filled hole with heavy mud
2. Pushed plug to 160'
3. Dumped 1/2 sack hulls on top of plug
4. Mixed 15 sacks cement and dumped on top of hulls
5. Filled hole to top
6. Pushed plug to 40'
7. Dumped in 1/2 sack hulls
8. Mixed 10 sacks cement and filled hole to top with same

1-6-1955
CONSERVATION DIVISION
WICHITA, KANSAS

(If additional description is necessary, use BACK of this sheet)
Name of Plugging Contractor Jones, Shelburne & Farmer, Inc.
Address Russell, Kansas

STATE OF Kansas COUNTY OF Russell, ss.
John O. Farmer (employee of owner) or (owner or operator) of the above-described well, being first duly sworn on oath, says: That I have knowledge of the facts, statements, and matters herein contained and the log of the above-described well as filed and that the same are true and correct. So help me God.

(Signature) John O. Farmer
Russell, Kansas
(Address)

SUBSCRIBED AND SWORN TO before me this 29th day of December, 19 54
Bennie Pratt

My commission expires July 14, 1958 Notary Public.

PLUGGING
FILE SEC. 26 T. 11 S. R. 15 W
BOOK PAGE 17 LINE 17


OPERATOR Jones, Shelburne & Farmer, Inc.

FORMATION RECORD

ADDRESS Russell, Kansas

Give detailed description and thickness of all formations drilled through, contents of sand, whether dry, water, oil or gas.

640 Acres
N

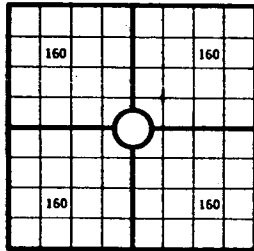

Locate well correctly

COUNTY Russell SEC 26 TWP 11 RGE 15
 COMPANY OPERATING Jones, Shelburne & Farmer, Inc.
 OFFICE ADDRESS Russell, Kansas
 FARM NAME Eulert WELL NO. 1
 DRILLING STARTED 12-16 1954 DRILLING FINISHED 12-28 1954
 DATE OF FIRST PRODUCTION _____ COMPLETED _____
 WELL LOCATED NE 1/4 NE 1/4 SW 1/4 North of South
 Line and _____ ft. East of West Line of Quarter Section.
 Elevation (Relative to sea level) DERRICK FLOOR 1886 GROUND
 CHARACTER OF WELL (Oil, gas or dryhole) dry

Formation	Top	Bottom	Formation	Top	Bottom
Shale	0	160			
Shale & sand	160	610			
Shale	610	720			
Sand	720	830			
Shale & shells	830	970			
Anhydrite	970	1000			
Shale & shells	1000	1110			
Shale & shells	1110	1575			
Lime & shale	1575	3390			

TOBS:
 Elevation 1890
 Heebner 2994
 Toronto 3015
 Lansing 3048
 Weathered Arb. 3362
 Arbuckle 3369
 T.D. 3390
 D & A

OIL OR GAS SANDS OR ZONES

Name	From	To	Name	From	To
1			4		
2			5		
3			6		

Perforating Record if Any

Shot Record

Formation	From	To	No. of Shots	Formation	From	To	Size of Shot

CASING RECORD

Amount Set						Amount Pulled		Packer Record			
Size	Wt.	Thds.	Make	Ft.	In.	Ft.	In.	Size	Length	Depth Set	Make
8 5/8				161							

Liner Record: Amount _____ Kind _____ Top _____ Bottom _____

CEMENTING AND MUDDING

Size	Amount Set		Sacks Cement	Chemical		Method of Cementing	Amount	Mudding Method	Results (See Note)
	Ft.	In.		Gal.	Make				
8 5/8	161		100						

Note: What method was used to protect sands if outer strings were pulled? _____

NOTE: Were bottom hole plugs used? _____ If so, state kind, depth set and results obtained _____

TOOLS USED

Rotary Tools were used from _____ feet to _____ Cable tools were used from _____ feet to _____

_____ feet, and from _____ feet to _____ feet, and from _____ feet to _____

Type Rig _____

INITIAL PRODUCTION TEST

Describe initial test: whether by flow through tubing or casing or by pumping _____

Amount of Oil Production _____ bbls. Size of choke, if any _____ Length of test _____ Water _____

Production _____ bbls. Gravity of oil _____ Type of Pump if pump is used, describe _____

I, the undersigned, being first duly sworn upon oath, state that this well record is true, correct and complete according to the records of this office and to the best of my knowledge and belief.

Shelburne Farmer ce. Pres.
 Name and title of representative of company

Subscribed and sworn to before me this 3rd day of January 1955
 My Commission expires July 14, 1958 Bonnie Pratt
 Notary Public.

PLUGGING
 FULL SEC 26 TWP 11 R 15W
 BOOK PAGE 44 LINE 11

FARM NAME Eulert WELL NO. 1 COUNTY Russell SEC 26 TWP 11 RGE 15