


WELL PLUGGING RECORD

Give All Information Completely
Make Required Affidavit
Mail or Deliver Report to:
Conservation Division
State Corporation Commission
211 No. Broadway
Wichita, Kansas

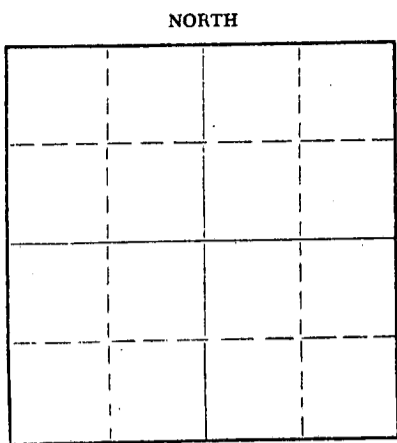

Locate well correctly on above Section Plat

Thomas County, Sec. 25 Twp. 10S Rge. (E) 32 (W)
Location as "NE/CNW/SW" or footage from lines. SE SE
Lease Owner Arvel C. Smith
Lease Name Beckman Well No. 1
Office Address 569 Stratford Road, Wichita 6, Kansas
Character of Well (completed as Oil, Gas or Dry Hole) Dry Hole
Date well completed July 3, 19 62
Application for plugging filed " " 19 "
Application for plugging approved " " 19 "
Plugging commenced " " 19 "
Plugging completed " " 19 "
Reason for abandonment of well or producing formation Dry Hole

If a producing well is abandoned, date of last production 19
Was permission obtained from the Conservation Division or its agents before plugging was commenced? Yes

Name of Conservation Agent who supervised plugging of this well Eldon Petty
Producing formation _____ Depth to top _____ Bottom _____ Total Depth of Well 4770 Feet
Show depth and thickness of all water, oil and gas formations.

OIL, GAS OR WATER RECORDS

CASING RECORD

FORMATION	CONTENT	FROM	TO	SIZE	PUT IN	PULLED OUT
Surface	Pipe	G.L.	297'	8 5/8"		No

Describe in detail the manner in which the well was plugged, indicating where the mud fluid was placed and the method or methods used in introducing it into the hole. If cement or other plugs were used, state the character of same and depth placed, from _____ feet to _____ feet for each plug set.

0' - 30' Ten sack cement plug.
30' - 240' Heavy Mud
240' - 300' Twenty sack cement plug
300' - 4770' Heavy mud.

RECEIVED
STATE CORPORATION COMMISSION
JUL 6 1962
07-06-1962
CONSERVATION DIVISION
Wichita, Kansas

(If additional description is necessary, use BACK of this sheet)
Name of Plugging Contractor Natural Gas Drilling, Inc.
Address Box 1615, Oklahoma City, Oklahoma

STATE OF Kansas, COUNTY OF Sedgwick, ss.
Arvel C. Smith. (employee of owner) or (owner or operator) of the above-described well, being first duly sworn on oath, says: That I have knowledge of the facts, statements, and matters herein contained and the log of the above-described well as filed and that the same are true and correct. So help me God.

(Signature) Arvel C. Smith
Arvel C. Smith
569 Stratford Road, Wichita 6, Kansas
(Address)

SUBSCRIBED AND SWORN to before me this 5th day of July, 19 62

Barbara F. Smith
Barbara F. Smith Notary Public.

My commission expires _____

- 15-193-30029-00-00
 WELL LOG BUREAU—KANSAS GEOLOGICAL SOCIETY
 508 East Murdock, Wichita, Kansas


COPY

Company- ARVEL C. SMITH
 Farm- Beckman No. 1

SEC. 25 T. 10 R. 32W
 C SE SE

Total Depth. 4770'
 Comm. 6-22-62 Comp. 7-3-62
 Shot or Treated.
 Contractor. Natural Gas Drilling
 Issued. 9-29-62

County Thomas
 KANSAS

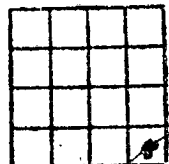

CASING:
 8 5/8" 297' cem w/250 sx.

Elevation. 3006' DF

Production. Dry

Figures Indicate Bottom of Formations.

soil, sand & clay	270
shale & clay	900
sand & shale	2270
shale & shaly sand	3020
shale & dolomite	3470
lime & shale; chert	4660
dolomite	4750
lime & chert	4765
lime & chert ?	4770
Total Depth	
TOPS: LOG	
Topeka	3810
Heebner	4004
Lansing	4044
Base Kansas City	4338
Marnaton	4355
Cherokee	4520
Conglomerate	4617
Spurgeon	4662
Warsaw	4694
Osage	4752