

STATE OF KANSAS  
STATE CORPORATION COMMISSION


Form CP-4

Give All Information Completely  
Make Required Affidavit  
Mail or Deliver Report to:  
Conservation Division  
State Corporation Commission  
P. O. Box 17027  
Wichita, Kansas 67217  
NORTH

WELL PLUGGING RECORD

Thomas County, Sec. 9 Twp. 10 Rge. 32 (E) 32W (W)

Location as "NE/CNW&SW" or footage from lines. C NE SW  
Lease Owner Donald C. Slawson  
Lease Name Saltzman 'A' Well No. 1  
Office Address 200 Douglas Building Wichita, Kansas 67202  
Character of Well (completed as Oil, Gas or Dry Hole) Dry Hole  
Date well completed March 25, 1979  
Application for plugging filed Mar. 25, 1979  
Application for plugging approved Mar. 25, 1979  
Plugging commenced Mar. 25, 1979  
Plugging completed Mar. 25, 1979  
Reason for abandonment of well or producing formation Dry Hole

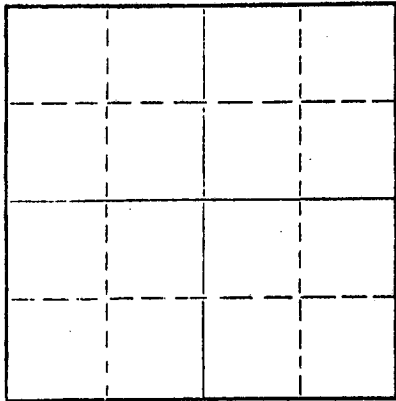

Locate well correctly on above Section Plat

If a producing well is abandoned, date of last production 19  
Was permission obtained from the Conservation Division or its agents before plugging was commenced? yes

Name of Conservation Agent who supervised plugging of this well Gilbert Balthazor  
Producing formation Depth to top Bottom Total Depth of Well 4760 Feet  
Show depth and thickness of all water, oil and gas formations.

OIL, GAS OR WATER RECORDS

CASING RECORD

FORMATION	CONTENT	FROM	TO	SIZE	PUT IN	PULLED OUT
	317.26'	surface	314'	8 5/8"		

Describe in detail the manner in which the well was plugged, indicating where the mud fluid was placed and the method or methods used in introducing it into the hole. If cement or other plugs were used, state the character of same and depth placed, from feet to feet for each plug set.

1st plug @ 1600' w/70 sx  
2nd plug @ 500' w/20 sx  
Solid Bridge @ 40' w/10 sx  
5 sx in Rat Hole

RECEIVED  
STATE CORPORATION COMMISSION  
4-30-79  
APR 30 1979

CONSERVATION DIVISION  
Wichita, Kansas


(If additional description is necessary, use BACK of this sheet)  
Name of Plugging Contractor SLAWSON DRILLING CO., INC.  
Address 200 Douglas Building Wichita, Kansas 67202

STATE OF KANSAS, COUNTY OF SEDGWICK, ss.  
R.J. THATCHER (employee of owner) or (owner or operator) of the above-described well, being first duly sworn on oath, says: That I have knowledge of the facts, statements, and matters herein contained and the log of the above-described well as filed and that the same are true and correct. So help me God.

(Signature) R.J. Thatcher  
R.J. THATCHER 200 Douglas Building, Wichita, Ks.  
(Address)

SUBSCRIBED AND SWORN TO before me this 22nd day of April, 1979

My commission expires 6/12/82

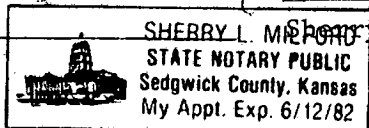

Sherry L. Milford Notary Public.

WELL LOG

OPERATOR: Donald C. Slawson  
 200 Douglas Building  
 Wichita, Kansas 67202

LEASE: #1 Saltzman 'A'  
 C NE SW of Sec. 9-10-32W  
 Thomas County, Kansas

CONTRACTOR: Slawson Drilling Company, Inc.  
 200 Douglas Building  
 Wichita, Kansas 67202

COMMENCED: March 15, 1979 Elev: Gr: 3077  
 Df: 3079

COMPLETED: March 25, 1979 Kb: 3082

CASING: Surface - 8 5/8" @ 314' w/225 sx 60/40 poz

0 - 169 Shale and sand  
 169 - 318 Surface  
 318 - 565 Shale and sand  
 565 - 1875 Shale and shells  
 1875 - 2609 Shale and sand  
 2609 - 2836 Anhydrite  
 2836 - 2978 Shale  
 2978 - 4050 Lime and shale  
 4050 - 4310 Lime  
 4310 - 4394 Lime and shale  
 4394 - 4420 Lime  
 4420 - 4470 Lime and shale  
 4470 - 4620 Lime  
 4620 - 4760 Lime and shale  
 4760 RTD

STATE OF KANSAS )  
 )  
 COUNTY OF SEDGWICK ) SS.

I, R.J. THATCHER, of the Slawson Drilling Company, Inc. do hereby state that the above and foregoing is a true and correct copy of the log of the #1 Saltzman 'A' test.

RECEIVED  
 STATE CORPORATION COMMISSION  
 APR 30 1979

CONSERVATION DIVISION  
 Wichita, Kansas

*R. J. Thatcher*  
 R.J. THATCHER

Subscribed and sworn to before me this 22nd day of April, 1979.

*Sherry L. Milford*  
 SHERRY L. MILFORD, Notary Public

My Commission Expires: 6/12/82

