


STATE OF KANSAS
STATE CORPORATION COMMISSION

Form CP-4

Give All Information Completely
Make Required Affidavit
Mail or Deliver Report to:
Conservation Division
State Corporation Commission

WELL PLUGGING RECORD

P. O. Box 17027
Wichita, Kansas 67217
NORTH

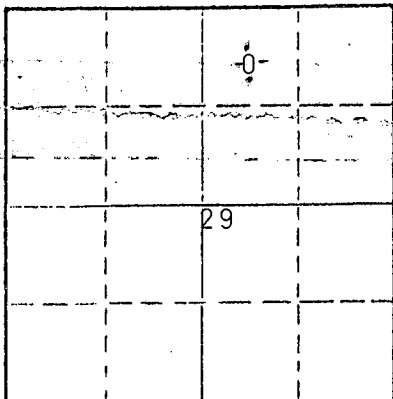

Locate well correctly on above
Section Plat

THOMAS County, Sec 29 Twp. 10 Rge. 32 (E) (West)
Location as "NE/CNW/SW" or footage from lines C NW NE
Lease Owner: Dane G. Hansen Trust
Lease Name: Broeckelman Well No. 1
Office Address: 1107 Union National Building
Character of Well (completed as: Oil, Gas or Dry Hole) Dry Hole
Date well completed May 2 1976
Application for plugging filed May 2 1976
Application for plugging approved May 2 1976
Plugging commenced May 2 1976
Plugging completed May 2 1976

Reason for abandonment of well or producing formation
TOO LOW STRUCTURALLY
If a producing well is abandoned, date of last production 19
Was permission obtained from the Conservation Division or its agents before plugging was commenced? Yes

Name of Conservation Agent who supervised plugging of this well W. L. Nichols, Morland, Kansas
Producing formation _____ Depth to top _____ Bottom _____ Total Depth of Well 4725 Feet
Show depth and thickness of all water, oil and gas formations.

OIL, GAS OR WATER RECORDS

CASING RECORD

FORMATION	CONTENT	FROM	TO	SIZE	PUT IN	PULLED OUT
				8 5/8"	310.53'	None

Describe in detail the manner in which the well was plugged, indicating where the mud fluid was placed and the method or methods used in introducing it into the hole. If cement or other plugs were used, state the character of same and depth placed, from _____ feet to _____ feet for each plug set.

Filled with heavy mud to 500'. Set plug. Put in 70 sacks cement. Filled with heavy mud to plug #2. Set plug. Put in 240 sacks cement. Filled with heavy mud to plug #3. Set plug. Put in 40 sacks cement.

5-19-76
MAY 19 1976

Conservation Division
Wichita, Kansas

(If additional description is necessary, use BACK of this sheet)

Name of Plugging Contractor _____
Address _____


STATE OF Kansas, COUNTY OF Sedgwick, ss.
G. F. Galloway (employee of owner) or (owner or operator) of the above-described

well, being first duly sworn on oath, says: That I have knowledge of the facts, statements, and matters herein contained and the log of the above described well as filed and that the same are true and correct. So help me God.

(Signature) G. F. Galloway
1107 Union National Building Wichita, Ks.
(Address)

Subscribed and sworn to before me this 3rd day of May, 1976

My commission expires December 8, 1979

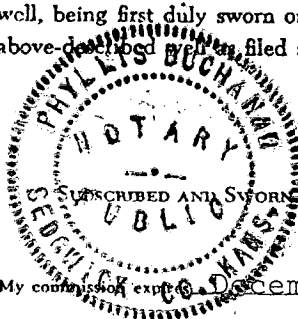

Phyllis Buchanan
Notary Public.