

Operator Name: Gilbert-Stewart Operating LLC Lease Name: DDK Well #: 8
 Sec. 22 Twp. 20s S. R. 12w East West County: Barton

INSTRUCTIONS: Show important tops and base of formations penetrated. Detail all cores. Report all final copies of drill stems tests giving interval tested, time tool open and closed, flowing and shut-in pressures, whether shut-in pressure reached static level, hydrostatic pressures, bottom hole temperature, fluid recovery, and flow rates if gas to surface test, along with final chart(s). Attach extra sheet if more space is needed. Attach copy of all Electric Wireline Logs surveyed. Attach final geological well site report.

Drill Stem Tests Taken <input checked="" type="checkbox"/> Yes <input type="checkbox"/> No <i>(Attach Additional Sheets)</i> Samples Sent to Geological Survey <input checked="" type="checkbox"/> Yes <input type="checkbox"/> No Cores Taken <input type="checkbox"/> Yes <input checked="" type="checkbox"/> No Electric Log Run <input checked="" type="checkbox"/> Yes <input type="checkbox"/> No <i>(Submit Copy)</i> List All E. Logs Run: DIL/MEL/Neu-Dens/Sonic	<input checked="" type="checkbox"/> Log Formation (Top), Depth and Datum <input type="checkbox"/> Sample <table style="width:100%; border-collapse: collapse;"> <tr> <td style="width:70%;">Name</td> <td style="width:15%;">Top</td> <td style="width:15%;">Datum</td> </tr> <tr> <td>Topeka</td> <td>2746</td> <td>-810</td> </tr> <tr> <td>Lansing</td> <td>3150</td> <td>-1314</td> </tr> <tr> <td>Arbuckle</td> <td>3384'</td> <td>-1548</td> </tr> </table>	Name	Top	Datum	Topeka	2746	-810	Lansing	3150	-1314	Arbuckle	3384'	-1548
Name	Top	Datum											
Topeka	2746	-810											
Lansing	3150	-1314											
Arbuckle	3384'	-1548											

CASING RECORD <input checked="" type="checkbox"/> New <input type="checkbox"/> Used							
Report all strings set-conductor, surface, intermediate, production, etc.							
Purpose of String	Size Hole Drilled	Size Casing Set (In O.D.)	Weight Lbs. / Ft.	Setting Depth	Type of Cement	# Sacks Used	Type and Percent Additives
Surface	12 1/4"	8 5/8"	24#	317'	Common	325	
Production	7 7/8"	5 1/2"	15.5#	3526'	60/40 Poz	150 sxs	4%Gel/2%CC/5%Calset

ADDITIONAL CEMENTING / SQUEEZE RECORD				
Purpose:	Depth Top Bottom	Type of Cement	#Sacks Used	Type and Percent Additives
<input type="checkbox"/> Perforate <input type="checkbox"/> Protect Casing <input type="checkbox"/> Plug Back TD <input type="checkbox"/> Plug Off Zone				

Shots Per Foot	PERFORATION RECORD - Bridge Plugs Set/Type Specify Footage of Each Interval Perforated	Acid, Fracture, Shot, Cement Squeeze Record <i>(Amount and Kind of Material Used)</i>	Depth
6SPF	3434-3440	750 gal of 15% Acetic	
6SPF	3418-3428	1000 gal of 15% Acetic	

TUBING RECORD		Size 2 7/8"	Set At 3475'	Packer At	Liner Run <input type="checkbox"/> Yes <input checked="" type="checkbox"/> No
Date of First, Resumerd Production, SWD or Enhr. 4-16-07		Producing Method <input type="checkbox"/> Flowing <input checked="" type="checkbox"/> Pumping <input type="checkbox"/> Gas Lift <input type="checkbox"/> Other (Explain)			
Estimated Production Per 24 Hours	Oil Bbls. 30	Gas Mcf	Water Bbls. 2	Gas-Oil Ratio	Gravity

Disposition of Gas Vented Sold Used on Lease *(If vented, Submit ACO-18.)*

METHOD OF COMPLETION Open Hole Perf. Dually Comp. Commingled Other (Specify) _____

Production Interval _____

RECEIVED
KANSAS CORPORATION COMMISSION

AUG 20 2007

GILBERT-STEWART OPERATING, LLC
DDK LEASE
SE. 1/4, SECTION 22, T20S, R12W
BARTON COUNTY, KANSAS

NO (SE. 40 ROAD) ROAD

Notes:

1. Set iron rod at location site.
2. All flagging Red & Yellow.
3. Overhead power available at S. & E. lines, Sec. 22.
4. Kansas One Call System Inc. should be notified before excavation (1-800-344-7233).
5. CAUTION: Various pipelines in Sec. 22.
6. Contact landowner for best access and as to location of iron rod in planted ground.
7. Location fell on the slope of a hill, set alternate 50' east per representative.
8. Location fell 15' outside of the pivot system, alternate fell 30' outside of the pivot system, contact landowner to verify.

DDK #1

DDK #7

(RIG)

22

Drillsite Location

DDK #8

2520'FSL 820'FEL

Ground Elevation = 1825

Y = 593690 X = 1962757

(Mapping Grade GPS Used)
 Kansas South - NAD 27

***Set iron rod at alternate 50' east of location**

2520'FSL 770'FEL

Ground Elevation = 1828

Y = 593690 X = 1962807

(Mapping Grade GPS Used)
 Kansas South - NAD 27

!CALCULATED! END OF PIVOT SYSTEM 15'SW. OF LOCATION (30'SW. OF ALTERNATE)

DDK #6

APPROX. LOCATION CENTER PIVOT IRR. SYSTEM


FARMSTEAD

FLAGGED ROAD OPPOSITE LOC.

DDK #5

FIELD ENTRANCE

PAVED (SE. 50 ROAD) ROAD
 DDK #4

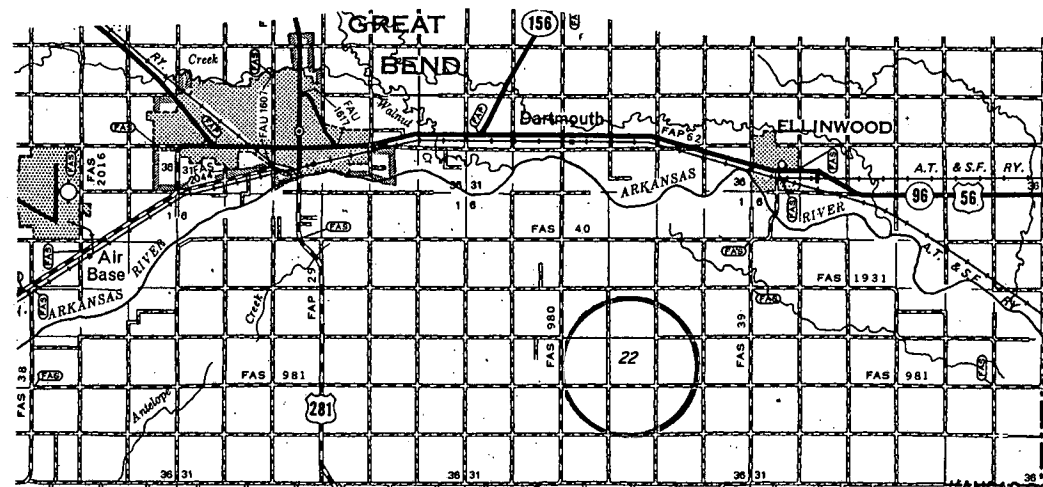

RECEIVED
 KANSAS CORPORATION COMMISSION

AUG 20 2007

CONSERVATION DIVISION
 WICHITA, KS


Date March 1, 2007

CENTRAL KANSAS OILFIELD SERVICES, INC. (620)792-1977

*Ingress and egress to location as shown on this plat is per usage only and may not be legally opened for public use. Contact landowner, tenant and county road department for access.

SCALE 1" = 1000'



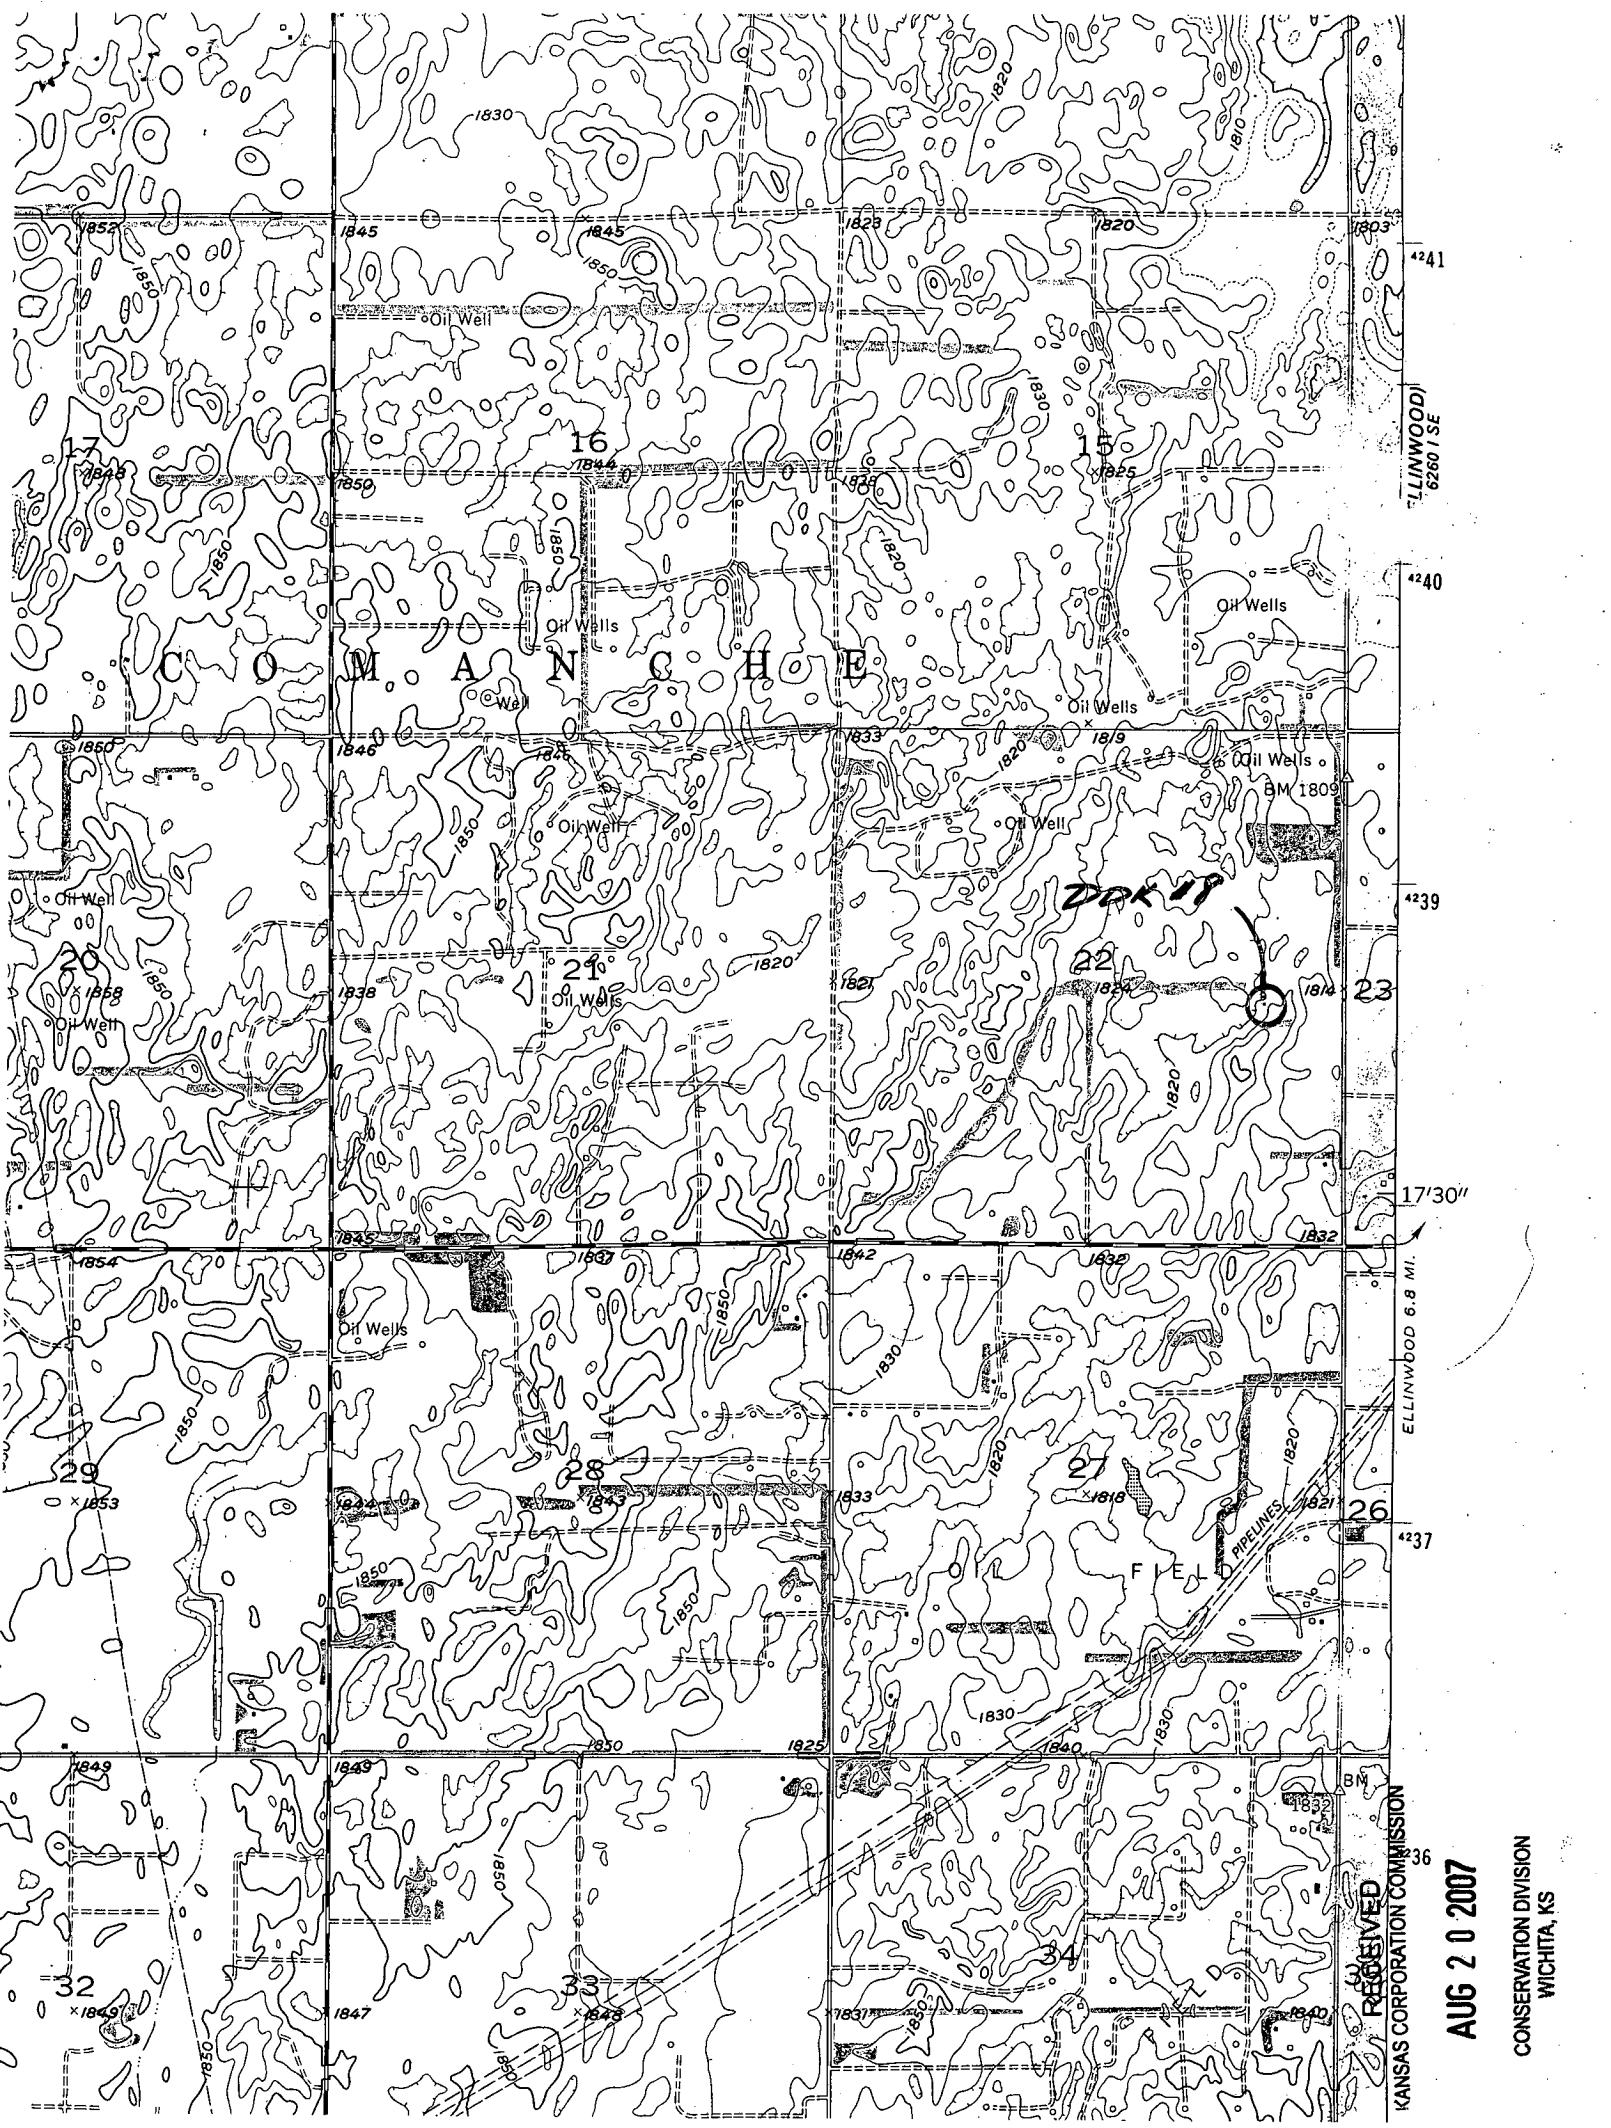

4241

ELLINWOOD
6250 I SE

4240

4239

17'30"

ELLINWOOD 6.8 MI.

4237

RECEIVED
KANSAS CORPORATION COMMISSION

AUG 20 2007

CONSERVATION DIVISION
WICHITA, KS

ALLIED CEMENTING CO., INC.

30134

REMIT TO P.O. BOX 31
RUSSELL, KANSAS 67665

SERVICE POINT: M.O.B.

DATE <u>3-18-07</u>	SEC <u>22</u>	TWP <u>20</u>	RANGE <u>12 W</u>	CALLED OUT <u>1 AM</u>	ON LOCATION <u>7 AM</u>	JOB START <u>4:50 AM</u>	JOB FINISH <u>2:45 PM</u>
LEASE <u>D.D.12</u>	WELL # <u>8</u>	LOCATION <u>Ellinwood 35 2w 1/2 S W 1/2</u>			COUNTY <u>Barber</u>	STATE <u>KS</u>	
OLD OR <input checked="" type="radio"/> NEW (Circle one)							

CONTRACTOR Southwind Rig 3

TYPE OF JOB Sue Sac

HOLE SIZE 12 1/4 T.D. 317 #

CASING SIZE 8 3/8 DEPTH 317 #

TUBING SIZE _____ DEPTH _____

DRILL PIPE _____ DEPTH _____

TOOL _____ DEPTH _____

PRES. MAX _____ MINIMUM _____

MEAS. LINE _____ SHOE JOINT _____

CEMENT LEFT IN CSG. 15 #

PERFS. _____

DISPLACEMENT 19.2536

OWNER _____

CEMENT AMOUNT ORDERED 325 ik Common
360 285

EQUIPMENT

PUMP TRUCK # 1461 CEMENTER Mike M
HELPER Randy

BULK TRUCK # 3114 DRIVER Marland

BULK TRUCK # _____ DRIVER _____

COMMON @ _____

POZMIX @ _____

GEL @ _____

CHLORIDE @ _____

ASC @ _____

_____ @ _____

_____ @ _____

_____ @ _____

_____ @ _____

_____ @ _____

_____ @ _____

HANDLING @ _____

MILEAGE _____

TOTAL _____

REMARKS:

circulate Hole with Rig mud Pump

Mix Cement + Release Plug

Displace Plug Down with water

SERVICE

DEPTH OF JOB 317 #

PUMP TRUCK CHARGE _____

EXTRA FOOTAGE @ _____

MILEAGE @ _____

MANIFOLD @ _____

RECEIVED @ _____

KANSAS CORPORATION COMMISSION

CHARGE TO: Hilbert - Stewart Oper

STREET _____

CITY _____ STATE _____ ZIP _____

AUG 20 2007

CONSERVATION DIVISION
WICHITA, KS

PLUG & FLOAT EQUIPMENT

To Allied Cementing Co., Inc. ...

You are hereby requested to rent cementing equipment and furnish cementer and helper to assist owner or contractor to do work as is listed. The above work was done to satisfaction and supervision of owner agent or contractor. I have read & understand the "TERMS AND CONDITIONS" listed on the reverse side.

1-8 1/2 wooden plug @ _____

_____ @ _____

_____ @ _____

_____ @ _____

_____ @ _____

SIGNATURE Jay Hrier

TAX _____

TOTAL CHARGE _____

DISCOUNT _____ IF PAID IN 30 DAYS

PRINTED NAME _____

GENERAL TERMS AND CONDITIONS

DEFINITIONS: In these terms and conditions, "Allied" shall mean Allied Cementing Co., Inc., and "Customer" shall refer to the party identified by that term on the front of this contract. As applicable, "Job" relates to the services described on the front side of this contract, "merchandise" refers to the material described on the front of this contract and to any other materials, products, or supplies used, sold, or furnished under the requirements of this contract.

—**TERMS:** Unless satisfactory credit has been established, "CUSTOMER" must tender full cash payment to "ALLIED" before the job is undertaken or merchandise is delivered. If satisfactory credit has been established, the terms of payment for the job and/or merchandise, including bulk cement, are net cash, payable in 30 days from the completion of the job and/or delivery of the merchandise. For all past due invoices, "CUSTOMER" agrees to pay interest on amounts invoiced at a rate of 18 percent per annum until paid. Notwithstanding the foregoing, in no event shall this Contract provide for interest exceeding the maximum rate of interest that "CUSTOMER" may agree to pay under applicable law. If any such interest should be provided for, it shall be and hereby is deemed to be a mistake, and this contract shall be automatically reformed to lower the rate of interest to the maximum legal contract rate, any amounts previously paid as excess interest shall be deducted from the amounts owing from the "CUSTOMER" or at the option of "ALLIED," refunded directly to "CUSTOMER." For purposes of this paragraph, ALLIED and CUSTOMER agree that KANSAS law shall apply. Any discounts granted with this contract are null and void if the charges are not paid when due.

—**ATTORNEY FEES:** In any legal action or proceeding between the parties to enforce any of the terms of this Service Contract, or in any way pertaining to the terms of this Contract, the prevailing party shall be entitled to recover all expenses, including, but not limited to, a reasonable sum as and for attorney's fees.

—**PRICES AND TAXES:** All merchandise listed in "ALLIED'S" current price schedule are F.O.B. ALLIED'S local station and are subject to change without notice. All prices are exclusive of any federal, state, local, or special taxes for the sale or use of the merchandise or services listed. The amount of taxes required to be paid by ALLIED shall be added to the quoted prices charged to CUSTOMER.

—**TOWING CHARGES:** ALLIED will make a reasonable attempt to get to and from each job site using its own equipment. Should ALLIED be unable to do so because of poor or inadequate road conditions, and should it become necessary to employ a tractor or other pulling equipment to get to or from the job site, the tractor or pulling equipment will be supplied by CUSTOMER or, if furnished by ALLIED, will be charged to and paid by CUSTOMER.

—**PREPARATION CHARGES:** If a job and/or merchandise is ordered and CUSTOMER cancels the order after preparation of a chemical solution or other material, CUSTOMER will pay ALLIED for the expenses incurred by ALLIED as a result of the cancellation.

—**DEADHAUL, CHARGES:** Unless otherwise specified on the front of this Contract, a deadhaul charge as set forth in ALLIED'S current price book will be charged each way for each service unit which is ordered by CUSTOMER but not used.

—**SERVICE CONDITIONS AND LIABILITIES:** 1. ALLIED carries public liability and property damage insurance, but since there are so many uncertain and unknown conditions beyond ALLIED'S control, ALLIED shall not be liable for injuries to property or persons or for loss or damage arising from the performance of the job or delivery of the merchandise. Customer shall be responsible for and indemnify, defend, and hold harmless ALLIED, its officers, agents and employees, from and against any and all claims or suits for:

(A) Damage to property or for bodily injury, sickness, disease, or death, brought by any person, including CUSTOMER and/or the well owner; and:

(B) Oil spills, pollution, surface or sub-surface damage, injury to the well, reservoir loss, or damage arising from a well blowout arising out of or in connection with ALLIED'S performance of the job or furnishing of merchandise in accordance with this contract, unless such loss or damage is caused by the willful misconduct or gross negligence of ALLIED or its employees.

2. With respect to any of ALLIED'S tools, equipment, or instruments which are lost in the well or damaged when performing or attempting to perform the job or, in the case of marine operations, are lost or damaged at any time after delivery to the landing for CUSTOMER and before return to ALLIED at the landing, CUSTOMER shall either recover the lost item without cost to ALLIED or reimburse ALLIED the current replacement cost of the item unless the loss or damage results from the sole negligence of ALLIED or its employees.

3. ALLIED does not assume any liability or responsibility for damages or conditions resulting from chemical action in cements caused by contamination of water or other fluids.

WARRANTIES: 1. ALLIED warrants all merchandise manufactured or furnished by it to be free from defects in material and workmanship under normal use and service when installed, and used, and/or serviced in the manner provided and intended. ALLIED'S obligation under this warranty is expressly limited to repair, replacement, or allowance for credit, at its option, for any merchandise which is determined by ALLIED to be defective. THIS IS THE SOLE WARRANTY OF ALLIED AND NO OTHER WARRANTY IS APPLICABLE, EITHER EXPRESS OR OTHERWISE IMPLIED, IN FACT OR IN LAW, INCLUDING ANY WARRANTY AS TO MERCHANTABILITY OR FITNESS FOR A PARTICULAR USE OR PURPOSE, CUSTOMER'S sole and only remedy with regard to any defective merchandise shall be the repair or replacement thereof or allowance for credit as herein provided, and ALLIED shall not be liable for any consequential, special, incidental, or punitive damages resulting from or caused by defective materials, products or supplies.

2. More specifically:

(A) Nothing in this contract shall be construed as a warranty by ALLIED of the success or the effectiveness of the result of any work done or merchandise used, sold, or furnished under this contract.

(B) Nothing in this contract shall be construed as a warranty of the accuracy or correctness of any facts, information, or data furnished by ALLIED or any interpretation of tests, meter readings, chart information, analysis of research, or recommendations made by ALLIED, unless the inaccuracy or incorrectness is caused by the wilful misconduct or gross negligence of ALLIED or its employees in the preparation or furnishing of such facts, information or data.

(C) Work done by ALLIED shall be under the direct supervision and control of the CUSTOMER or his agent and ALLIED will accomplish the job as an independent contractor and not as an employee or agent of the CUSTOMER.