


Give All Information Completely  
Make Required Affidavit  
Mail or Deliver Report to:  
Conservation Division  
State Corporation Commission  
211 No. Broadway  
Wichita, Kansas

WELL PLUGGING RECORD

15-065-00567-00-00

NORTH

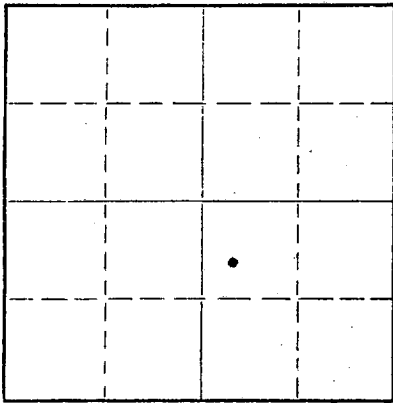

Locate well correctly on above  
Section Plat

Graham County. Sec. 21 Twp. 9S Rge. 23W (X) (W)  
Location as "NE/CNWxSWx" or footage from lines. C-SW/4-NW/4-SE/4  
Lease Owner Amerada Petroleum Corporation  
Lease Name B.F. Prescott Well No. 2  
Office Address Box 197, Great Bend, Kansas  
Character of Well (completed as Oil, Gas or Dry Hole) Dry Hole  
Date well completed 5-27- 1958  
Application for plugging filed 5-28- 1958  
Application for plugging approved \_\_\_\_\_ 19\_\_\_\_  
Plugging commenced 7:30 PM 5-27- 1958  
Plugging completed 11:00 PM 5-27- 1958  
Reason for abandonment of well or producing formation Dry Hole

If a producing well is abandoned, date of last production \_\_\_\_\_ 1958  
Was permission obtained from the Conservation Division or its agents before plugging was commenced? Yes

Name of Conservation Agent who supervised plugging of this well A.D. Fabricius, Hill City, Kansas  
Producing formation \_\_\_\_\_ Depth to top \_\_\_\_\_ Bottom \_\_\_\_\_ Total Depth of Well 3959 Feet  
Show depth and thickness of all water, oil and gas formations.

OIL, GAS OR WATER RECORDS

CASING RECORD

FORMATION	CONTENT	FROM	TO	SIZE	PUT IN	PULLED OUT
				8-5/8"	1369'	None

Describe in detail the manner in which the well was plugged, indicating where the mud fluid was placed and the method or methods used in introducing it into the hole. If cement or other plugs were used, state the character of same and depth placed, from \_\_\_\_\_ feet to \_\_\_\_\_ feet for each plug set.

Filled Hole W/Heavy Mud to 1365'  
Spotted Cement Plug Thru 4-1/2" Drill Pipe from 1365' to 1290' W/25 Sacks Cement  
Filled Hole W/Heavy Mud to 500'  
Spotted Cement Plug Thru 4-1/2" Drill Pipe From 500' to 440' W/15 Sacks Cement  
Filled Hole W/Heavy Mud to 40'  
Spotted Cement Plug Thru 4-1/2" Drill Pipe from 40' to Top W/10 Sacks Cement  
Finished at 11:00 PM 5-27-58


RECEIVED  
STATE CORPORATION COMMISSION  
6-2-58  
JUN 2 1958  
CONSERVATION DIVISION  
Wichita, Kansas

(If additional description is necessary, use BACK of this sheet)  
Name of Plugging Contractor Peel Brothers Inc.  
Address Box 88, Hoisington, Kansas

STATE OF Kansas, COUNTY OF Barton, ss.  
Ernest Higgins (employee of owner) of the above-described well, being first duly sworn on oath, says: That I have knowledge of the facts, statements, and matters herein contained and the log of the above-described well as filed and that the same are true and correct. So help me God.

(Signature) Ernest Higgins  
Box 197, Great Bend, Kansas  
(Address)

SUBSCRIBED AND SWORN TO before me this 28th day of May, 1958  
Charles W. Anderson  
Notary Public.

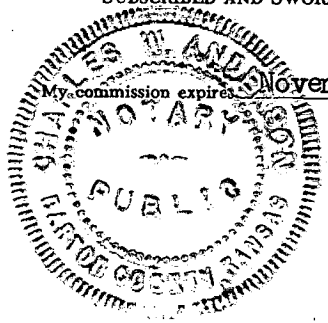

PLUGGING  
FILE SEC. 21 T. 9 R. 23W  
BOOK PAGE 103 LINE 45

DRILLERS' LOG

Well Owner:	Amerada Petroleum Corporation	C SW NW SE
Farm Name:	B. F. Prescott Well No. 2	Sec. 21-9S-23W
Commenced:	5/19/58	Graham County, Kansas
Completed:	5/27/58	
Total Depth:	3959'	Elevation: 2397 KB
Casing:	8 5/8" @ 1369' cemented	Production: Dry
Contractor:	Glenn W. Peel	

Figures below indicate bottoms of formations:

Surface soils	0	40
Shale and shells		875
Shale and sand streaks		1115
Shale and shells		1372
Red bed and shale		2204
Shale		2535
Shale and lime		2835
Lime		2950
Shale and lime		3240
Lime		3330
Shale and lime		3590
Lime		3959
Total Depth		3959

This is to certify that the above information is to the best of our knowledge, true and correct.

GLENN W. PEEL

BY *Jack Matlock*

SUBSCRIBED AND SWORN to before me this 29th day of May, 1958

My commission expires: April 27, 1960

*Ruth Beak*  
Notary Public



RECEIVED  
STATE CORPORATE COMMISSION

JUN 2 1958

CONSERVATION DIVISION  
Wichita, Kansas

LOG  
 FILE SEC 21 T 9 R 23W  
 PAGE 103 45