


STATE OF KANSAS  
STATE CORPORATION COMMISSION

WELL PLUGGING RECORD

Give All Information Completely  
Make Required Affidavit  
Mail or Deliver Report to  
Conservation Division  
State Corporation Comm.  
245 North Water  
Wichita, KS 67202

Graham County. Sec. 21 Twp. 9S Rge. 23W E/W  
Location as "NE/CNW $\frac{1}{4}$ SW $\frac{1}{4}$ " or footage from lines SW SW NE  
Lease Owner Tomlinson Oil Co., Inc.  
Lease Name RIFFLE Well No. 1  
Office Address Suite 1030, 200 W. Douglas, Wichita, Ks. 67202  
Character of Well (Completed as Oil, Gas or Dry Hole) Dry Hole  
Date Well completed October 13 1976  
Application for plugging filed (Verbally) October 13 1976  
Application for plugging approved (Verb.) October 13 1976  
Plugging commenced October 13 1976  
Plugging completed October 13 1976  
Reason for abandonment of well or producing formation No commercial quantity of oil or gas encountered  
If a producing well is abandoned, date of last production 19

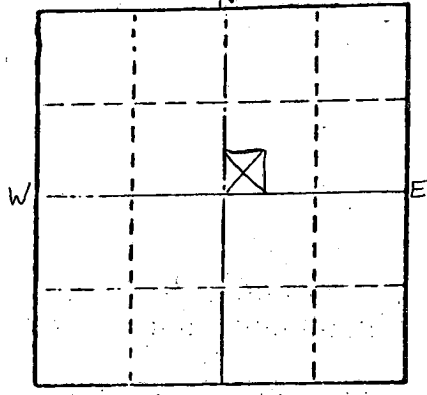

Locate well correctly on above Section Plot

Name of Conservation Agent who supervised plugging of this well \_\_\_\_\_  
Producing formation \_\_\_\_\_ Depth to top \_\_\_\_\_ Bottom \_\_\_\_\_ Total Depth of Well \_\_\_\_\_  
Show depth and thickness of all water, oil and gas formations.

OIL, GAS OR WATER RECORDS

CASING RECORD

| FORMATION | CONTENT | FROM | TO | SIZE | PUT IN | PULLED OUT |
|-----------|---------|------|----|------|--------|------------|
|           |         |      |    |      |        |            |
|           |         |      |    |      |        |            |
|           |         |      |    |      |        |            |

Describe in detail the manner in which the well was plugged, indicating where the mud fluid was placed and the method or methods used in introducing it into the hold. If cement or other plugs were used, state the character of same and depth placed, from \_\_\_\_\_ feet to \_\_\_\_\_ feet for each plug set.

Set 1st plug at 1050' with 70 sx.  
2nd plug at 200' with 20 sx.  
3rd plug at 40' with 10 sx. - 50/50 posmix.

Plug was down at 4:00 a.m. 10-13-76  
State Plugger - Gilbert Balthazor, Palco, Kansas

RECEIVED  
STATE CORPORATION COMMISSION  
10-20-76  
OCT 20 1976  
CONSERVATION DIVISION  
Wichita, Kansas

(If additional description is necessary, use BACK of this sheet)

Name of Plugging Contractor Abercrombie Drilling, Inc.


STATE OF Kansas COUNTY OF Sedgwick ss.  
Jack L. Partridge, Asst. Sec.-Treas. (employee of owner) or (owner or operator) of the above-described well, being first duly sworn on oath, says: That I have knowledge of the facts, statements, and matters herein contained and the log of the above-described well as filed and that the same are true and correct. So help me God.

(Signature) Jack L. Partridge  
801 Union Center, Wichita, Kansas 67202  
(Address)

Subscribed and Sworn to before me this 18th day of October, 1976

My commission expires \_\_\_\_\_

Kathy S. Goertz  
Kathy S. Goertz Notary Public.

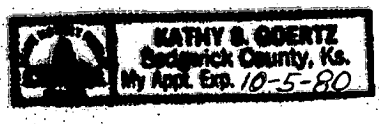

CONTRACTOR'S WELL LOG

OPERATOR: Tomlinson Oil Co., Inc.  
 CONTRACTOR: Abercrombie Drilling, Inc.  
 WELL NAME: RIFFLE #1  
 LOCATION: SW SW NE, Section 21-9S-23W  
 Graham County, Kansas  
 SPUD DATE: October 7, 1976  
 COMPLETION DATE: October 13, 1976  
 2432' KB

|      |      |                    |
|------|------|--------------------|
| 0    | 135  | Surface Clay       |
| 135  | 180  | Sand               |
| 180  | 486  | Shale              |
| 486  | 1425 | Shale - Sand       |
| 1425 | 1570 | Shale              |
| 1570 | 1775 | Sand               |
| 1775 | 2031 | Shale              |
| 2031 | 2068 | Anhydrite          |
| 2068 | 2744 | Shale              |
| 2744 | 3109 | Shale & Lime       |
| 3109 | 3265 | Shale              |
| 3265 | 3517 | Shale & Lime       |
| 3517 | 3667 | Shale              |
| 3667 | 3780 | Lime & Shale       |
| 3780 | 3995 | Lime               |
|      | 3995 | Rotary Total Depth |

Spud at 5:00 p.m. 10-07-76. Cut 213' of 12 1/4" hole. Ran 5 jts. of 8 5/8" casing. (Tally 205')  
 Set at 212' K.B. with 175 sx. Sun Quickset cement. Cement did circulate.

T.D. 3995', Set 1st plug at 1050' with 70 sx., 2nd plug at 200' with 20 sx., 40' bridge with  
 10 sx. - 50/50 posmix. Plug was down at 4:00 a.m. 10-13-76. State Plugger - Gilbert  
 Balthazor, Palco, Kansas.

RECEIVED  
 STATE CORPORATION COMMISSION  
 OCT 20 1976  
 CONSERVATION DIVISION  
 Wichita, Kansas

SAMPLE TOPS:  
 Anhydrite 2031'  
 B/Anhydrite 2068'

STATE OF KANSAS )  
 ) SS  
 COUNTY OF SEDGWICK )

Jack L. Partridge, Assistant Secretary-Treasurer of Abercrombie Drilling, Inc. does hereby  
 state that the above and foregoing is a true and correct copy of the log of the RIFFLE #1,  
 SW SW NE, Section 21-9S-23W, Graham County, Kansas.

ABERCROMBIE DRILLING, INC.

BY: Jack L. Partridge  
 Jack L. Partridge, Asst. Sec.-Treas.

COPY

Subscribed and sworn to before me, a Notary Public, in and for the aforesaid county and state  
 as of this 18th day of October, 1976.



Kathy S. Goertz  
 Kathy S. Goertz, Notary Public