


STATE OF KANSAS
STATE CORPORATION COMMISSION

WELL PLUGGING RECORD

Give All Information Completely
Make Required Affidavit
Mail or Deliver Report to
Conservation Division
State Corporation Comm.
245 North Water
Wichita, KS 67202

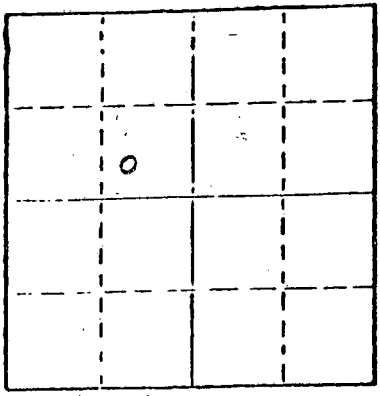

Thomas County, Sec. 15 Twp. 10 Rge. 33W E/W
Location as "NE/CNW 1/4 SW 1/4" or footage from lines
1650' FWL 500' FSL NW/4
Lease Owner Donald C. Slawson & Petroleum, Inc.
Lease Name Nollette 'O' Well No. 3
Office Address 408 One Twenty Building, Wichita, Ks. 67202
Character of Well (Completed as Oil, Gas or Dry Hole)
Dry Hole

Date Well completed March 9, 1977
Application for plugging filed March 9, 1977
Application for plugging approved March 9, 1977
Plugging commenced March 9, 1977
Plugging completed March 9, 1977
Reason for abandonment of well or producing formation
Dry Hole

If a producing well is abandoned, date of last production
19

Was permission obtained from the Conservation Division or
its agents before plugging was commenced? YES

Name of Conservation Agent who supervised plugging of this well Gilbert Balthazor
Producing formation Depth to top Bottom Total Depth of Well 4400
Show depth and thickness of all water, oil and gas formations.

OIL, GAS OR WATER RECORDS

CASING RECORD

FORMATION	CONTENT	FROM	TO	SIZE	PUT IN	PULLED OUT
8 5/8"	374'				372'	

Describe in detail the manner in which the well was plugged, indicating where the mud fluid was placed and the method or methods used in introducing it into the hold. If cement or other plugs were used, state the character of same and depth placed, from feet to feet for each plug set.

1st plug @ 1600' with 70 sacks
2nd plug @ 350' with 20 sacks
3rd plug @ 40' with 10 sacks
2 sacks in rathole

RECEIVED
STATE CORPORATION COMMISSION
3-28-77
MAR 28 1977

CONSERVATION DIVISION
Wichita, Kansas

(If additional description is necessary, use BACK of this sheet)

Name of Plugging Contractor Donald C. Slawson Drilling Co. Inc.
408 One Twenty Bldg. Wichita, Kansas 67202

STATE OF Kansas COUNTY OF Sedgwick, ss.
R.J. Thatcher (employee of owner) or (owner or operator)

of the above-described well, being first duly sworn on oath, says: That I have knowledge of the facts, statements, and matters herein contained and the log of the above-described well as filed and that the same are true and correct. So help me God.

(Signature)

R.J. Thatcher
R.J. Thatcher
(Address)

SUBSCRIBED AND SWORN TO before me this 24th day of March, 1977

Margene Hamer
Margene Hamer, Notary Public.

My commission expires 11/9/80



WELL LOG

OPERATOR: Donald C. Slawson & Petroleum, Inc.
 408 One Twenty Building
 Wichita, Kansas 67202

LEASE: #3 Nollette '0'
 1650' FWL 500' FSL NW/4 Sec. 15-10-33W
 Thomas County, Kansas

CONTRACTOR: Slawson Drilling Company, Inc.

COMMENCED: March 2, 1977

COMPLETED: March 9, 1977

CASING: Surface - 8 5/8" @ 372' w/225 sx 60/40 poz
 Elevation: GR: 3156
 DF: 3158
 KB: 3161

0 - 374	Surface hole
374 - 1825	Shale and Shells and Sand
1825 - 2670	Shale and Shells
2670 - 2706	Anhydrite
2706 - 3000	Shale and Shells
3000 - 3405	Shale
3405 - 4305	Shale and Lime
4305 - 4400	Lime
4400	RTD

RECEIVED
STATE CORPORATION COMMISSION

MAR 28 1977

STATE OF KANSAS)
) SS.
 COUNTY OF SEDGWICK)

CONSERVATION DIVISION
Wichita, Kansas

I, R.J. Thatcher, of the Slawson Drilling Company, Inc. upon oath state that the above and foregoing is a true and correct copy of the log of the #3 Nollette '0' well.

R.J. Thatcher

 R.J. Thatcher

Subscribed and sworn to before me this 24th. day of March, 1977.

MarGene Hamer

 MarGene Hamer, Notary Public

My Commission Expires: 11/9/80

