


15-193-30031-0000

STATE OF KANSAS  
STATE CORPORATION COMMISSION

WELL PLUGGING RECORD

Give All Information Completely  
Make Required Affidavit  
Mail or Deliver Report to:  
Conservation Division  
State Corporation Commission  
212 North Market, Insurance Bldg.  
Wichita, Kansas

Thomas County, Sec. 31 <sup>SW</sup> Twp. 10S Rge. (E) 33 (W)  
Location as "NE/CNW%SW%" or footage from lines C 31/4 SE/4  
Lease Owner Target Drilling Corporation  
Lease Name Kaiser Well No. 1  
Office Address 910 Enterprise Building, Tulsa, Oklahoma  
Character of Well (completed as Oil, Gas or Dry Hole) Dry Hole  
Date well completed 10-19 19 61  
Application for plugging filed 10-19 19 61  
Application for plugging approved 10-19 19 61  
Plugging commenced 10-19 19 61  
Plugging completed 10-19- 19 61  
Reason for abandonment of well or producing formation No productive horizons encountered  
If a producing well is abandoned, date of last production \_\_\_\_\_ 19\_\_\_\_  
Was permission obtained from the Conservation Division or its agents before plugging was commenced? yes

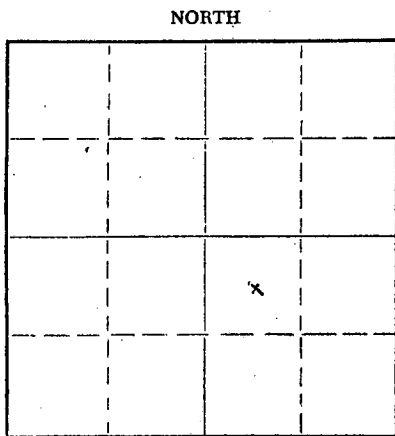

Name of Conservation Agent who supervised plugging of this well Eldon Petty  
Producing formation None Depth to top X Bottom X Total Depth of Well 4807 Feet  
Show depth and thickness of all water, oil and gas formations.

OIL, GAS OR WATER RECORDS

CASING RECORD


FORMATION	CONTENT	FROM	TO	SIZE	PUT IN	PULLED OUT
<u>Water Sand</u>	<u>Fresh Water</u>	<u>15</u>	<u>70'</u>	<u>8 5/8</u>	<u>188"</u>	<u>None</u>

Describe in detail the manner in which the well was plugged, indicating where the mud fluid was placed and the method or methods used in introducing it into the hole. If cement or other plugs were used, state the character of same and depth placed, from \_\_\_\_\_ feet to \_\_\_\_\_ feet for each plug set.

Set cement plug at 550' with twenty sacks cement, filled hole with mud to 180' and set cement plug with twenty sacks cement, filled hole with mud to 30' from surface, and set plug with ten sacks cement with two wires attached to plug and extending to surface.

RECEIVED  
STATE CORPORATION COMMISSION  
OCT 24 1961  
CONSERVATION DIVISION  
Wichita, Kansas

(If additional description is necessary, use BACK of this sheet)  
Name of Plugging Contractor Halliburton Company  
Address Hays, Kansas

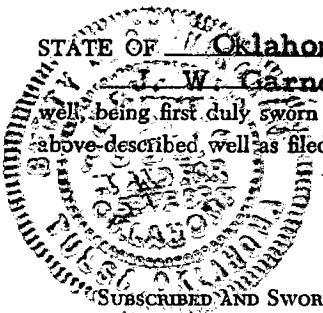

STATE OF Oklahoma, COUNTY OF Tulsa, ss.  
J. W. Garner (employee of owner) or (owner or operator) of the above-described well, being first duly sworn on oath, says: That I have knowledge of the facts, statements, and matters herein contained and the log of the above-described well as filed and that the same are true and correct. So help me God.

(Signature) J. W. Garner  
(Address) \_\_\_\_\_

SUBSCRIBED AND SWORN TO before me this 23 day of October, 19 61  
Betty J. Cunningham  
Notary Public.  
My commission expires March 24, 1965