


STATE OF KANSAS
STATE CORPORATION COMMISSION
200 Colorado Derby Bldg.
Wichita, Kansas 67202

WELL PLUGGING RECORD

Give All Information Completely
Make Required Affidavit

COUNTY Thomas SEC. 32 TWP. 10S RGE. 33W ~~XY~~W
Location as in quarters or footage from lines:
C NW

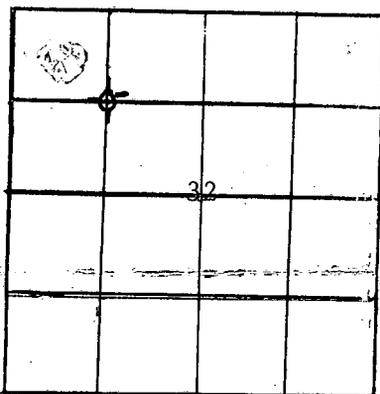

Locate Well
correctly on above
Section Platt.

Lease Owner Corie Oil Company
Lease Name Dumler Well No. #1
Office Address West Wichita Ave., Russell, KS 67665
Character of Well (Completed as Oil, Gas or Dry Hole): Dry Hole
Date Well Completed December 9, 1982
Application for plugging filed Yes
Plugging commenced _____
Plugging completed 3:00 A.M., 12-9-82
Reason for abandonment of well or producing formation _____

Was permission obtained from the Conservation Division or it's
Agent's before plugging was commenced? Yes

Name of Conservation Agent who supervised plugging of this well Carl Goodrow

Producing formation _____ Depth to top _____ bottom T.D. 4785'

Show depth and thickness of all water, oil and gas formations.

OIL, GAS OR WATER RECORDS

Casing Record

Formation	Content	From	To	Size	Put in	Pulled Out
				8-5/8"	309' 312'	

Describe in detail the manner in which the well was plugged, indicating where the mud
fluid was placed and the method or methods used in introducing it into the hold. If cement
or other plugs were used, state the character of same and depth placed, from _____ feet
to _____ feet for each plug set.

- Plug #1 @ 2680' w/20 sks. cement
- Plug #2 @ 1300' w/100 sks. cement
- Plug #3 @ 320' w/40 sks. cement
- Plug #4 @ 40' w/10 sks. cement
- 10 sks. cement in rathole

(If additional description is necessary, use BACK of this sheet)

Name of Plugging Contractor John O. Farmer, Inc.
P.O. Box 352, Russell, KS 67665

STATE OF Kansas COUNTY OF Russell, ss. Operator (~~employee of owner~~) or (~~owner~~ or operator) of the
above-described well, being first duly sworn on oath, says: That I have knowledge of the
facts, statements, and matters herein contained and the log of the above-described well as
filed and that the same are true and correct. So help me God

(Signature) Carroll Mull
(Address) _____

SUBSCRIBED AND SWORN TO before me this 29 day of December, 1982



Dorothy Mashburn RECEIVED
STATE CORPORATION COMMISSION
Notary Public.

My Commission expires: 12-18-84

DEC 30 1982