

STATE CORPORATION COMMISSION OF KANSAS
OIL & GAS CONSERVATION DIVISION

WELL COMPLETION OR RECOMPLETION FORM
ACO-1 WELL HISTORY

DESCRIPTION OF WELL AND LEASE

Operator: License # 5184
Name Shields Oil Producers, Inc.
Address Shields Bldg.
City/State/Zip Russell, Kansas 67665

Purchaser None

Operator Contact Person M. L. Ratts
Phone 913-483-3141

Contractor: License # 5655
Name Shields Drlg. Co. Inc.

Wellsite Geologist Francis Whisler
Phone 913-483-3020

Designate Type of Completion

- New Well Re-Entry Workover
- Oil SWD Temp Abd
- Gas Inj Delayed Comp.
- Dry Other (Core, Water Supply etc.)

If OWWO: old well info as follows:

Operator
Well Name
Comp. Date Old Total Depth

WELL HISTORY

Drilling Method:

- Mud Rotary Air Rotary Cable

8-5-85 8-10-85 8-10-85
Spud Date Date Reached TD Completion Date

3010
Total Depth PBD

Amount of Surface Pipe Set and Cemented at 490 feet
Multiple Stage Cementing Collar Used? Yes No
If yes, show depth set feet
If alternate 2 completion, cement circulated from feet depth to w/SX cmt

API NO. 15-167-22,640-00-00

County Russell

SE SW SW Sec 16 Twp 11 Rge 12 East West

330 Ft North from Southeast Corner of Section
4290 Ft West from Southeast Corner of Section
(Note: Locate well in section plat below)


Lease Name Beverly "A" Well # 1

Field Name Wildcat

Producing Formation None

Elevation: Ground 1610 KB 1615

Section Plat

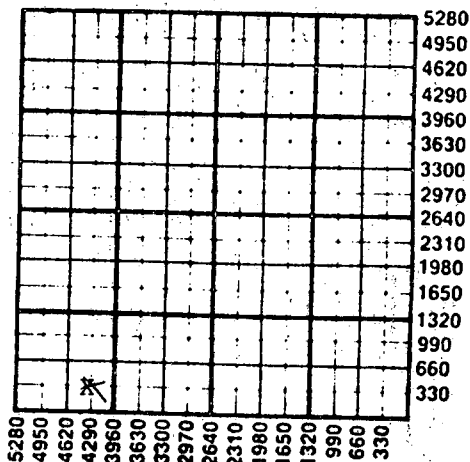

WATER SUPPLY INFORMATION

Disposition of Produced Water: Disposal Repressuring
Docket #

Questions on this portion of the ACO-1 call:
Water Resources Board (913) 296-3717

Source of Water:
Division of Water Resources Permit # T 85-688

- Groundwater Ft North from Southeast Corner (Well) Ft West from Southeast Corner Sec Twp Rge East West
- Surface Water 3960 Ft North from Southeast Corner (Stream, pond etc) 50 Ft West from Southeast Corner Sec Twp Rge East West
- Other (explain) (purchased from city, R.W.D. #)

INSTRUCTIONS: This form shall be completed in duplicate and filed with the Kansas Corporation Commission, 200 Colorado Derby Building, Wichita, Kansas 67202, within 90 days after completion or recompletion of any well. Rule 82-3-130 and 82-3-107 apply. Information on side two of this form will be held confidential for a period of 12 months if requested in writing and submitted with the form. See rule 82-3-107 for confidentiality in excess of 12 months. One copy of all wireline logs and drillers time log shall be attached with this form. Submit CP-4 form with all plugged wells. Submit CP-111 form with all temporarily abandoned wells.

All requirements of the statutes, rules and regulations promulgated to regulate the oil and gas industry have been fully complied with and the statements herein are complete and correct to the best of my knowledge.

Signature M. L. Ratts

Title Production Supt Date 8-14-85

Subscribed and sworn to before me this 14th day of August 1985

Notary Public Ruth Phillips

Date Commission Expires



K.C.C. OFFICE USE ONLY
F Letter of Confidentiality Attached
C Wireline Log Received
C Drillers Timelog Received
Distribution
 KCC SWD/Rep NGPA
 KGS Plug Other (Specify)

RECEIVED STATE CORPORATION COMMISSION

AUG 26 1985
08-26-1985
CONSERVATION DIVISION
Wichita

Form ACO-1 (7-84)

Sec. 16 Twp. 11 Rge. 12 W

SIDE TWO

Operator Name Shields Oil Producers, Inc. Lease Name Beverly "A" Well # 1

Sec. 16 Twp. 11 Rge. 12 East West County Russell

WELL LOG

INSTRUCTIONS: Show important tops and base of formations penetrated. Detail all cores. Report all drill stem tests giving interval tested, time tool open and closed, flowing and shut-in pressures, whether shut-in pressure reached static level, hydrostatic pressures, bottom hole temperature, fluid recovery, and flow rates if gas to surface during test. Attach extra sheet if more space is needed. Attach copy of log.

Drill Stem Tests Taken Yes No
 Samples Sent to Geological Survey Yes No
 Cores Taken Yes No

Formation Description
 Log Sample

Name	Top	Bottom
Anhydrite	619	658
Grandhaven Lm	2214	2218
Tarkio Lm	2289	2310
Topeka Lm	2571	2810
Heebner Sh	2810	2814
Toronto Lm	2833	2843
Lansing - K.C.	2870	R.T.D.

CASING RECORD <input checked="" type="checkbox"/> New <input type="checkbox"/> Used Report all strings set-conductor, surface, intermediate, production, etc.							
Purpose of String	Size Hole Drilled	Size Casing Set (in O.D.)	Weight Lbs/Ft.	Setting Depth	Type of Cement	#Sacks Used	Type and Percent Additives
Surface	12 1/4	8 5/8	24	490	Quickset	250	None
PERFORATION RECORD				Acid, Fracture, Shot, Cement Squeeze Record			
Shots Per Foot	Specify Footage of Each Interval Perforated			(Amount and Kind of Material Used)			Depth
TUBING RECORD		Size	Set At	Packer at	Liner Run	<input type="checkbox"/> Yes <input type="checkbox"/> No	
Date of First Production		Producing Method					
		<input type="checkbox"/> Flowing <input type="checkbox"/> Pumping <input type="checkbox"/> Gas Lift <input type="checkbox"/> Other (explain).....					
Estimated Production Per 24 Hours		Oil	Gas	Water	Gas-Oil Ratio	Gravity	
		Bbls	MCF	Bbls	CFPB		

METHOD OF COMPLETION

Production Interval

Disposition of gas: Vented Open Hole Perforation
 Sold Other (Specify)
 Used on Lease Dually Completed
 Commingled