

15-051-00161-00-00

STATE OF KANSAS
STATE CORPORATION COMMISSION


Give All Information Completely
Make Required Affidavit
Mail or Deliver Report to:
Conservation Division
State Corporation Commission
800 Bitting Building
Wichita, Kansas

WELL PLUGGING RECORD

Ellis County. Sec. 31 Twp. 11 Rge. 16 (E) 16 (W)
Location as "NE/CNW/SW" or footage from lines SE SE SW

Lease Owner Graham-Miller Oil Company
Lease Name Planters State Bank "A" Well No. 1
Office Address 1005 E. Second Street, Wichita, Kansas

Character of Well (completed as Oil, Gas or Dry Hole) Dry Hole
Date well completed October 4, 1953
Application for plugging filed October 4, 1953
Application for plugging approved October 4, 1953
Plugging commenced October 4, 1953
Plugging completed October 4, 1953
Reason for abandonment of well or producing formation Dry

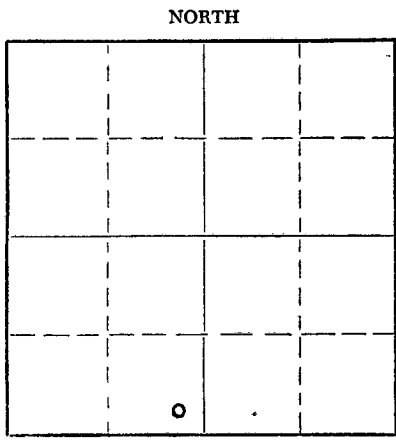

Locate well correctly on above Section Plat

If a producing well is abandoned, date of last production _____ 19____
Was permission obtained from the Conservation Division or its agents before plugging was commenced? yes

Name of Conservation Agent who supervised plugging of this well Mr. Eldon Petty, Box 326, Hays, Kansas
Producing formation _____ Depth to top _____ Bottom _____ Total Depth of Well 3565 Feet
Show depth and thickness of all water, oil and gas formations.

OIL, GAS OR WATER RECORDS

CASING RECORD

FORMATION	CONTENT	FROM	TO	SIZE	PUT IN	PULLED OUT
				8 5/8"	170'	none

Describe in detail the manner in which the well was plugged, indicating where the mud fluid was placed and the method or methods used in introducing it into the hole. If cement or other plugs were used, state the character of same and depth placed, from _____ feet to _____ feet for each plug set.


Bottom plug at 165 ft. with 1/2 sk. hulls and 15 sx. cement. Filled hole with mud. Top plug at 40 ft. with 1/2 sk. hulls and 10 sx. cement. Mud to surface

STATE CORPORATION COMMISSION
OCT 12 1953
10-12-1953
CONSERVATION DIVISION
Wichita, Kansas

(If additional description is necessary, use BACK of this sheet)
Name of Plugging Contractor Graham-Messman-Rinehart Oil Company
Address 1005 E. Second Street, Wichita, Kansas

STATE OF Kansas, COUNTY OF Sedgwick, ss.
J. A. Gilliland (employee of owner) ~~of the above-described~~
well, being first duly sworn on oath, says: That I have knowledge of the facts, statements, and matters herein contained and the log of the above-described well as filed and that the same are true and correct. So help me God.
(Signature) J. A. Gilliland
1005 E. Second Street, Wichita, Kansas
(Address)

SUBSCRIBED AND SWORN to before me this 8th day of October, 19 53
December 1, 1956
Barbara J. Scott Notary Public.

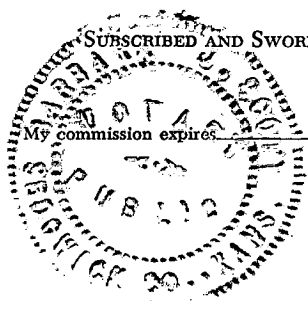

PLUGGING
FILE OCT 31 T 11 R 16W
BOOK PAGE 134 LINE 29

WELL RECORD

Location: SE SE SW 31-11-16W
Ellis County, Kansas

Commenced: September 24, 1953

Operator: Greenhart-Miller Oil Company
1005 E. 2nd Street, Wichita, Kansas

Completed: October 4, 1953

Elevation: 1973 K.B.

Contractor: Graham-Messman-Rinehart Drilling Company
1005 E. 2nd Street, Wichita, Kansas

Production: D & A

Casing Record: 8 5/8" @ 170' with 110 ex. con.

L.O.G

Shale & Sand	110
Shale & Shells	162
Shale & Shells	500
Sand	600
Shale	700
Sand	785
Shale	845
Shale & Red Bed	1144
Anhydrite	1189
Shale & Shells	1325
Shale & Shells	1755
Lime & Shale	2000
Lime & Shale	2130
Lime & Shale	2270
Lime & Shale	2405
Lime & Shale	2520
Shale & Lime	2665
Lime & Shale	2800
Lime & Shale	2945
Lime & Shale	3015
Lime & Shale	3065
Lime	3082
Lime & Shale	3180
Lime	3245
Lime	3295
Lime	3298
Lime	3350
Lime	3415
Lime	3465
Conglomerate	3503
Arbuckle	3552
Arbuckle	3565 T.D.

TOPS

- Anhydrite - 1189 (-784)
- Keokuk - 3155 (-1182)
- *Toronto - 3174 (-1201)
- Conglomerate - 3467 (-1494)
- Arbuckle - 3498 (-1525)
- *Lanning - 3195 (-1222)

10-13-1953

The undersigned, GRAHAM-MESSMAN-RINEHART DRILLING COMPANY, hereby certifies that the above log is a true and correct log of the formation encountered in drilling the above well as reflected by the Daily Drilling Reports.

GRAHAM-MESSMAN-RINEHART DRILLING COMPANY

By: J. A. Gilliland
J. A. Gilliland

Subscribed and sworn to before me this 8th day of October, 1953.

Bessie J. Scott
Notary Public

My commission expires: December 1, 1956

PLUGGING
FILE SEC. 31 T. 11 R. 16W
BOOK PAGE 134 LINE 29

