

15-051-01468-00-00

STATE OF KANSAS  
STATE CORPORATION COMMISSION


WELL PLUGGING RECORD

Give All Information Completely  
Make Required Affidavit  
Mail or Deliver Report to:  
Conservation Division  
State Corporation Commission  
211 No. Broadway  
Wichita, Kansas

Ellis County, Sec. 31 Twp. 11S Rge. 16W (W)

Location as "NE/CNW/SW" or footage from lines SW NE NW  
Lease Owner Mayfield-Smith Drlg., Inc. & Floyd W. Smith & Co., Inc.  
Lease Name Planters State Bank "A" Well No. 1  
Office Address 928 Union Center, Wichita, Kansas  
Character of Well (completed as Oil, Gas or Dry Hole) Dry Hole  
Date well completed October 24 19 62  
Application for plugging filed " 19 62  
Application for plugging approved " 19 62  
Plugging commenced " 19 62  
Plugging completed " 19 62  
Reason for abandonment of well or producing formation  
Oil in commercial quantities not found.  
If a producing well is abandoned, date of last production - - - 19  
Was permission obtained from the Conservation Division or its agents before plugging was commenced? Yes

NORTH

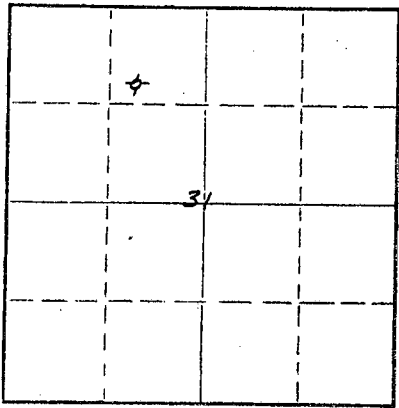

Locate well correctly on above Section Plat

Name of Conservation Agent who supervised plugging of this well Eldon Petty, Hays, Kansas  
Producing formation - - Depth to top - - Bottom - - Total Depth of Well 3480' Feet  
Show depth and thickness of all water, oil and gas formations.

OIL, GAS OR WATER RECORDS

CASING RECORD

FORMATION	CONTENT	FROM	TO	SIZE	PUT IN	PULLED OUT
				8 5/8"	199'	None

Describe in detail the manner in which the well was plugged, indicating where the mud fluid was placed and the method or methods used in introducing it into the hole. If cement or other plugs were used, state the character of same and depth placed, from - - - feet to - - - feet for each plug set.

Filled hole to 500' with heavy rotary mud.  
Set #1 Plug @ 500' with 20 Sks. Cement through drill pipe.  
Set #2 Plug @ 119' with 20 Sks. Cement through drill pipe.  
Top Plug @ 40', cemented to base of cellar.

RECEIVED  
STATE CORPORATION COMMISSION  
11-14-1962  
NOV 14 1962  
CONSERVATION DIVISION  
Wichita, Kansas

(If additional description is necessary, use BACK of this sheet)  
Name of Plugging Contractor Mayfield-Smith Drilling, Inc.  
Address 928 Union Center Bldg., Wichita 2, Kansas

STATE OF KANSAS COUNTY OF SEDGWICK  
Charles R. Mayfield, ss.  
(employee of owner) or (owner or operator) of the above-described well, being first duly sworn on oath, says: That I have knowledge of the facts, statements, and matters herein contained and the log of the above-described well as filed and that the same are true and correct. So help me God.

(Signature) Charles R. Mayfield  
928 Union Center Bldg., Wichita 2, Kansas  
(Address)

SUBSCRIBED AND SWORN to before me this 12th day of November, 19 62

My commission expires 10-26-65  
Marguerite Mayfield  
Notary Public.



