

WELL PLUGGING RECORD


Give All Information Completely  
Make Required Affidavit  
Mail or Deliver Report to:  
Conservation Division  
State Corporation Commission  
211 No. Broadway  
Wichita, Kansas

Ellis

County. Sec. 31 Twp. 11S Rge. 16W (E) (W)

Location as "NE/CNW/SW" or footage from lines C S/2 SW NW  
Lease Owner Mayfield-Smith Drigl, Inc. & Floyd W. Smith & Co.  
Lease Name Planters State Bank Well No. 1  
Office Address 928 Union Center, Wichita, Kansas  
Character of Well (completed as Oil, Gas or Dry Hole) - - -  
Date well completed October 13 19 62  
Application for plugging filed " 19 62  
Application for plugging approved " 19 62  
Plugging commenced " 19 62  
Plugging completed " 19 62  
Reason for abandonment of well or producing formation  
Wrong location.  
If a producing well is abandoned, date of last production - - - 19  
Was permission obtained from the Conservation Division or its agents before plugging was commenced?

NORTH

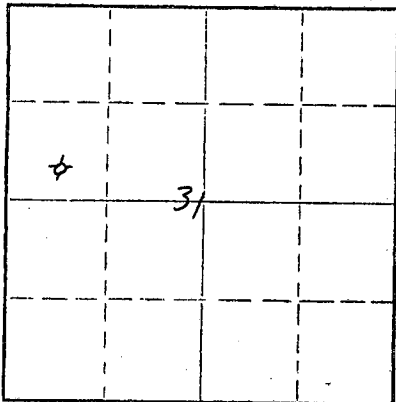

Locate well correctly on above Section Plat

Name of Conservation Agent who supervised plugging of this well  
Producing formation Depth to top Bottom Total Depth of Well 3080 Feet  
Show depth and thickness of all water, oil and gas formations.

OIL, GAS OR WATER RECORDS

CASING RECORD

FORMATION	CONTENT	FROM	TO	SIZE	PUT IN	PULLED OUT
				8 5/8"	292 1/3"	None

Describe in detail the manner in which the well was plugged, indicating where the mud fluid was placed and the method or methods used in introducing it into the hole. If cement or other plugs were used, state the character of same and depth placed, from feet to feet for each plug set.

Filed hole to 500' with heavy rotary mut.  
Set #1 Plug @ 500' with 20 sks. cement through drill pipe.  
Set #2 Plug @ 240' with 20 Sks. cement through drill pipe.  
Set top plug @ 40' bridged with rock cement to bottom of cellar.

**RECEIVED**  
STATE CORPORATION COMMISSION  
11-14-1962  
NOV 14 1962

CONSERVATION DIVISION  
Wichita, Kansas

Name of Plugging Contractor Mayfield-Smith Drilling, Inc. (If additional description is necessary, use BACK of this sheet)  
Address 928 Union Center Bldg., Wichita, Kansas

STATE OF KANSAS COUNTY OF SEDGWICK ss.  
Charles R. Mayfield (employee of owner) or (owner or operator) of the above-described well, being first duly sworn on oath, says: That I have knowledge of the facts, statements, and matters herein contained and the log of the above-described well as filed and that the same are true and correct. So help me God.

(Signature) Charles R. Mayfield (Address)

SUBSCRIBED AND SWORN TO before me this 12th day of November, 19 62

Auguste Mayfield Notary Public.

