


Give All Information Completely
Make Required Affidavit
Mail or Deliver Report to:
Conservation Division
State Corporation Commission
211 No. Broadway
Wichita, Kansas

WELL PLUGGING RECORD

Graham County. Sec. 27 Twp. 9 Rge. 23 (E) (W)
Location as "NE/CNW&SW&" or footage from lines SE NW SE
Lease Owner Martin & Keller
Lease Name Law Well No. 1
Office Address 713 Kennedy, Tulsa, Oklahoma
Character of Well (completed as Oil, Gas or Dry Hole) Dry Hole
Date well completed December 19 19 62
Application for plugging filed December 19 19 62
Application for plugging approved December 19 19 62
Plugging commenced December 19 19 62
Plugging completed December 19 19 62
Reason for abandonment of well or producing formation Too low Structurally

If a producing well is abandoned, date of last production _____ 19____
Was permission obtained from the Conservation Division or its agents before plugging was commenced? Yes

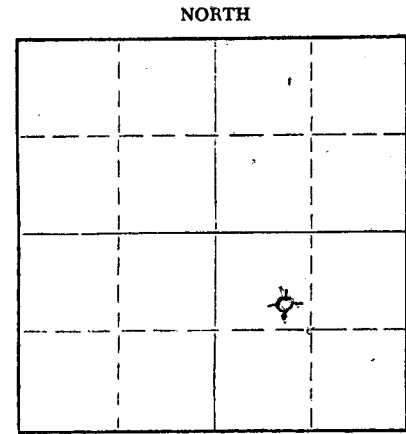

Locate well correctly on above Section Plat

Name of Conservation Agent who supervised plugging of this well Eldon Petty, Hays, Kansas
Producing formation _____ Depth to top _____ Bottom _____ Total Depth of Well 3975' Feet
Show depth and thickness of all water, oil and gas formations.

OIL, GAS OR WATER RECORDS

CASING RECORD

FORMATION	CONTENT	FROM	TO	SIZE	PUT IN	PULLED OUT
				8-5/8"	206.27'	None

Describe in detail the manner in which the well was plugged, indicating where the mud fluid was placed and the method or methods used in introducing it into the hole. If cement or other plugs were used, state the character of same and depth placed, from _____ feet to _____ feet for each plug set.

Filled hole with heavy mud to 207'. Set plug. Put in 30 sacks cement. Filled with heavy mud to 35'. Set plug. Filled to top with 1/2 sack hulls and 20 sacks cement.

RECEIVED
STATE CORPORATION COMMISSION

JAN 2 1963

CONSERVATION DIVISION
Wichita, Kansas

1-2-63

(If additional description is necessary, use BACK of this sheet)

Name of Plugging Contractor C-G Drilling Co.
Address 107 Rule Building, Wichita 2, Kansas

STATE OF Kansas, COUNTY OF Sedgwick, ss.
G. F. Galloway (employee of owner) or (owner or operator) of the above-described well, being first duly sworn on oath, says: That I have knowledge of the facts, statements, and matters herein contained and the log of the above-described well as filed and that the same are true and correct. So help me God.

(Signature) G. F. Galloway
107 Rule Building
(Address)

Subscribed and Sworn to before me this 21st day of December, 1962
My commission expires May 30, 1963
Vicky Jacobs
Notary Public.



15-065-02638-00-00

W E L L L O G

OPERATOR Martin & Keller SEC. 27-9-23
 WELL NAME Law #1 LOC. SE NW SE
 TOTAL DEPTH 3975' COUNTY Graham
 COMM. 12/9/62 COMP. 12/19/62 STATE Kansas
 RIG NO. 2 ELEVATION 2435 K.B.
 CASING: Set 206' (5 jts.) 8-5/8" OD Surface Casing. PRODUCTION: D & A

All measurements taken from the top of rotary bushing.

FROM	TO	FORMATION	DEVIATION FROM VERTICAL	REMARKS:
0	1460	Shale	1000' - 0°	
1460	1720	Sand	1500' - 0°	
1720	2006	Red Bed		
2006	2040	Anhydrite		
2040	2560	Shale-Shells	2200' - 0°	
2560	3610	Lime-Shale	2720' - 0°	
3610	3658	Lime-Shale	3060' - 0°	
3658	3975	Lime	3658' - 0°	

#1 DST 3810-3840
 #2 DST 3873-3898
 #3 DST 3909-3940

RECEIVED
STATE CORPORATION COMMISSION

JAN 2 1963
1-2-63
CONSERVATION DIVISION
Wichita, Kansas

STATE OF KANSAS)
) SS.
COUNTY OF SEDGWICK)

The undersigned hereby certifies that to the best of his knowledge and belief, the above facts are true and correct.

C-G DRILLING CO.
By G. F. Galloway
G. F. Galloway

SUBSCRIBED AND SWORN TO, BEFORE ME, THIS 21 day of December, 1962.
My commission expires: May 20, 1963
Vicky Jacobs
Vicky Jacobs - Notary Public

